the seizure by me made, by virtue of the said Writs of Fieri Facias before mentio-
-oned, have been exposed to sale at public vendue and purchased by Daniel
Wheaton of the Dist & State aforesaid for the sum of Twenty six Dollars being the
highest sum that was bidden therefor - Now Know Ye that I William M
Goodett Sheriff aforesaid by virtue of the said Writ of Fieri Facias aforesaid
to me directed and delivered as aforesaid and by virtue of the Statute in such
case made and provided and for and in consideration of the said sum of Twen-
-ty six dollars to me in hand paid or secured to be paid by the said Daniel
Wheaton the receipt and payment whereof I do hereby acknowledge, have gr-
-anted bargained and sold and by these presents do grant bargain and
sell unto the said Daniel Wheaton his heirs and Assigns forever, the said
tract piece and parcel of Land with its Appurtenances and all the est-
-tate, right, title and interest which the said Robert Pearce of right had
of in and to the same. To Have and to hold the said piece parcel and
tract of Land with its Appurtenances, unto the said Daniel Wheaton
his heirs and Assigns forever as fully and absolutely as I the said W.
M. Goodlett might, could or ought to grant, bargain and sell the same
by virtue of the Statute aforesaid, and the said Writs of Fieri Facias
or otherwise. In Witness Whereof, I the said W. M. Goodlett Sheriff have
hereunto set my hand and seal the Twenty First day of September
in the Year of our Lord One thousand Eight hundred & Forty
signed sealed and delivered in the presence

of M. B. Earle } W. M. Goodlett (L.D.)
A. McBee } S. G. D.

South Carolina } Personally came Alexander McBee before
Greenville District } me and made Oath that he did see W. M
Goodlett Shff sign seal and Acknowledge the within deed of conv-
-eyance for the use and purposes therein mentioned and that
M. B. Earle was with himself a subscribing witness to the due
Execution of the same this 21st Sept 1840 Sworn to & subscribed
Before Me W. Blasingame J. Dun } A. McBee

Recorded for 21st Sept 1840

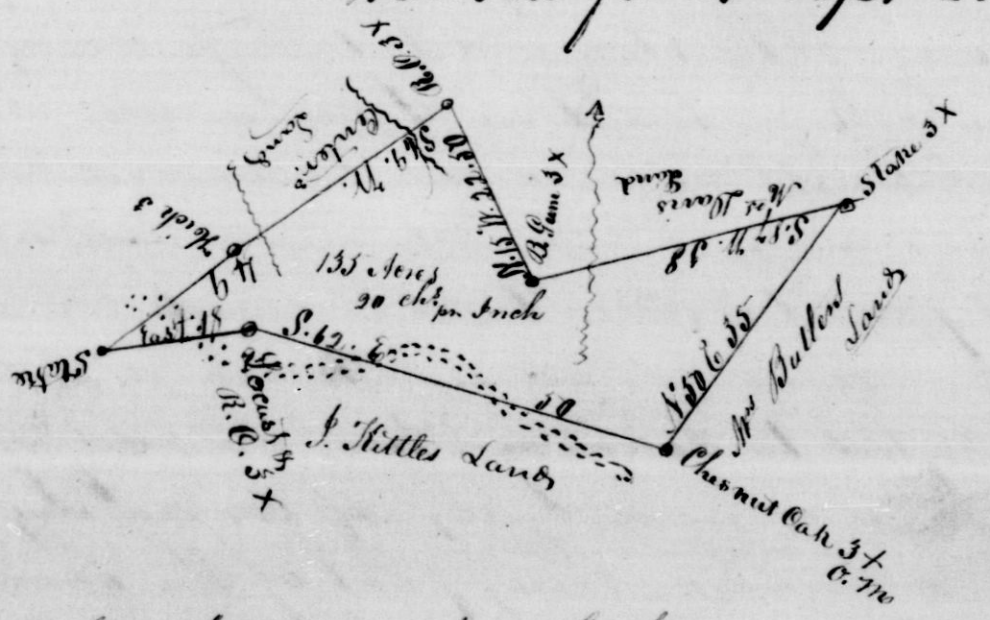

Resurveyed Sept 12th 1840 John C. Hoyt
188 D.S.

Recorded for 21st Sept 1840