



Settled on before the 21 March 1784, Surveyed before me the 27th day of July 1784. W. B. Benson

State of South Carolina
pursuant to a warrant from John Thomas Esq. Commissioner of Location dated the 21st day of May 1784. I have admeasured & laid out unto Zadock Ford a tract of five hundred acres of land situate in 96 District on Enore river Bounding to Southwest on land laid out to John Pennington by Enore River on the South East on land not known & on all other sides by vacant land and hath such shapes & marks as the above plate represents.
Surveyed this 18th day of June 1784 W. B. Benson
Recorded the 7th July 1784
Delivered to Zadock Ford

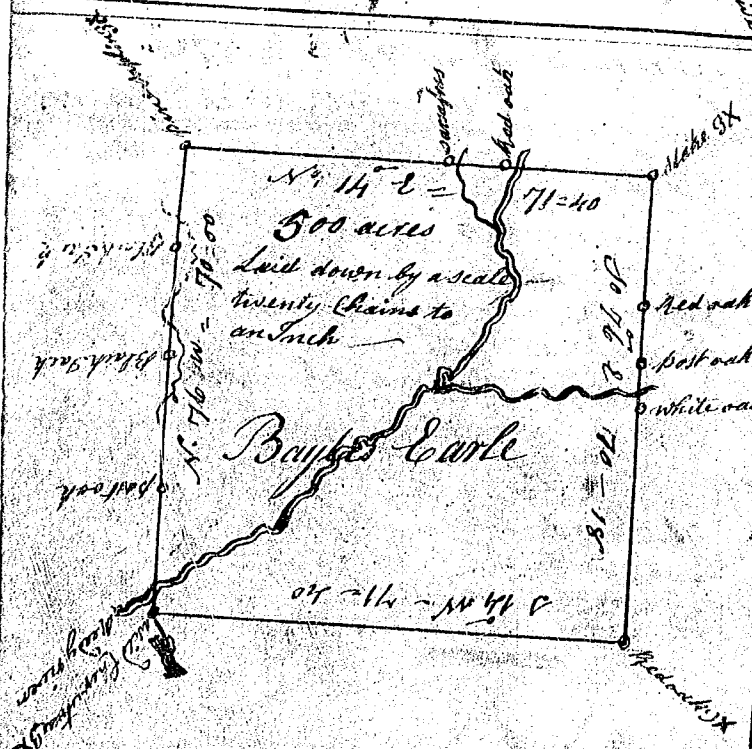

State of South Carolina
pursuant to a warrant from John Thomas Esq. Commissioner of Location, and agreeable to a resolve and ordinance which passed both branches the Legislature of this State I have admeasured and laid out unto Bayles Earle Esq. a tract of Land containing five hundred acres situate in ninety six district on Needy River about two miles above Rich. parsons place on said river and hath such shape and marks as the above plat represents.
Surveyed this seventh day of July 1784.
Recorded the 8th day of July 1784, W. B. Benson
Delivered to Bayles Earle

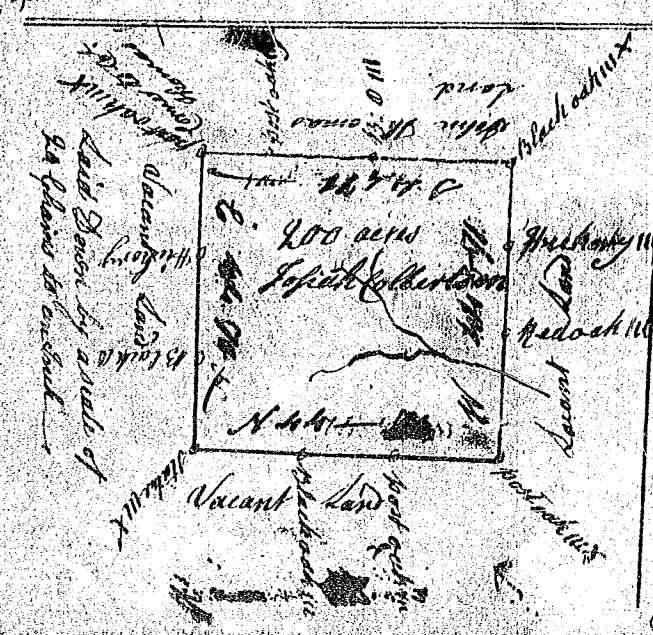

State of South Carolina 96 District
Pursuant to a warrant from under the hand and seal of John Thomas Esq. Commissioner of Location on the North side of Saluda river bearing date the 21st day of May 1784. I have admeasured and laid out unto Joseph Albertsons a tract of Land containing two hundred acres bounded lastly on John Thomas's land above the Indian boundary, waters of Tyeer River & on all other sides on vacant land & hath such other shapes & marks as the above plat represents.
Surveyed and Certified by me this 9th day of June 1784. W. B. Benson
Recorded the 9th July 1784
Delivered to said Mr. Albertsons