


State of South Carolina (100)

Pursuant to a warrant from John Thomas Esq<sup>r</sup> Commissioner of Locations I have Admeasured and laid out unto John McCutchen, a tract of one hundred & thirty five acres of land, situate in Ninety six District on the waters of Calous creek Bounding NW. on land Unknown SW. on land Unknown E. on Hughston S. on Vacant land NE on Patrick Lowrey & Widow Glasco, and hath set such shape and marks as the above plat represents Survey<sup>d</sup> the 22<sup>nd</sup> Sept. 1784 Ben. Glen. D<sup>y</sup>  
Recorded the 1<sup>st</sup> Oct. 1784 Deliv<sup>d</sup> to John McCutchen




State of South Carolina Pursuant to a warrant from John Thomas Esq<sup>r</sup> Commissioner of Locations, dated the 20<sup>th</sup> day of July 1784, I have admeasured and laid out unto Crawford Goodwin a tract of one hundred and fifty acres of land, situate in Ninety six District, West of the ancient Boundary line, N. side of the Santee River, Bounding N.W. on land laid out to Capt. Maxwell & Co by the S. River, and all other sides Vacant, & hath set such shape and marks as the annexed Plat represents Survey<sup>d</sup> this 26<sup>th</sup> day of July 1784

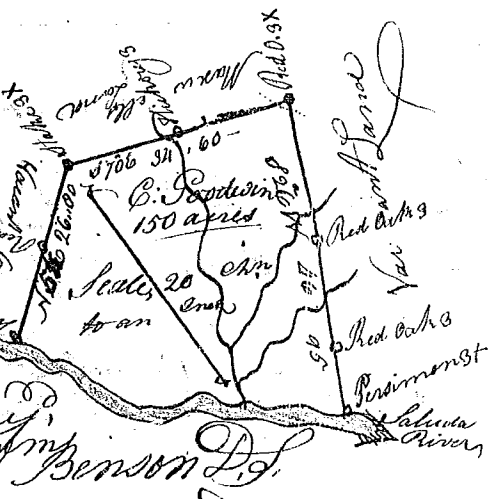

State of South Carolina pursuant to a warrant from John Thomas Esq<sup>r</sup> Comm<sup>r</sup> Locations I have Admeasured and laid out a tract of one hundred & fifty acres unto Duncan McKeever, situate in Ninety six District on the waters of Broad River Bounding N.W. on Vacant land & said River N.E. on Hugh Nelsons land & Westland and hath set such shape and marks as the annexed Plat represents Survey<sup>d</sup> the 26<sup>th</sup> Aug. 1784 D. Hopkins D<sup>y</sup>  
Recorded the 1<sup>st</sup> Oct. 1784



State of South Carolina Pursuant to a warrant from John Thomas Esq<sup>r</sup> Comm<sup>r</sup> Locations I have Admeasured and laid out unto Duncan McKeever a tract of one hundred acres situate in Ninety six District on the waters of Broad River Bounding S.W. on Richard Addis all other sides Vacant land and hath set such shape and marks as the annexed Plat represents Survey<sup>d</sup> the 26<sup>th</sup> Aug. 1784 D. Hopkins D<sup>y</sup>

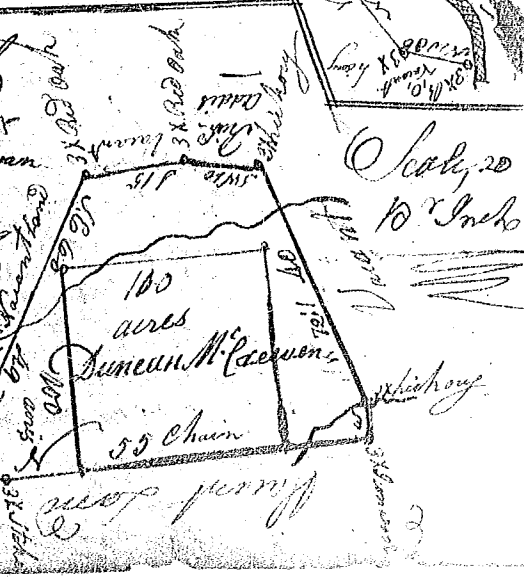

Recorded the 1<sup>st</sup> Oct. 1784