


State of S<sup>c</sup> Carolina Pursuant to a

18A

Warrant from John Thomas Esq<sup>r</sup> Commissioner  
of Locations dated sixth day July 1784 I have  
admeasured & laid out unto James & George  
a tract of five hundred acres of land  
situated in Ninety six District, West of  
the ancient Boundary line on the  
Branches of Enore & Catapha swamps  
of the Upper River bounding  
on James & George Hite, all  
other ways vacant & hath such  
shape & marks as the annexed  
plat represents Survey the 12<sup>th</sup> day  
Recorded the 16<sup>th</sup> day of Oct<sup>r</sup> 1784

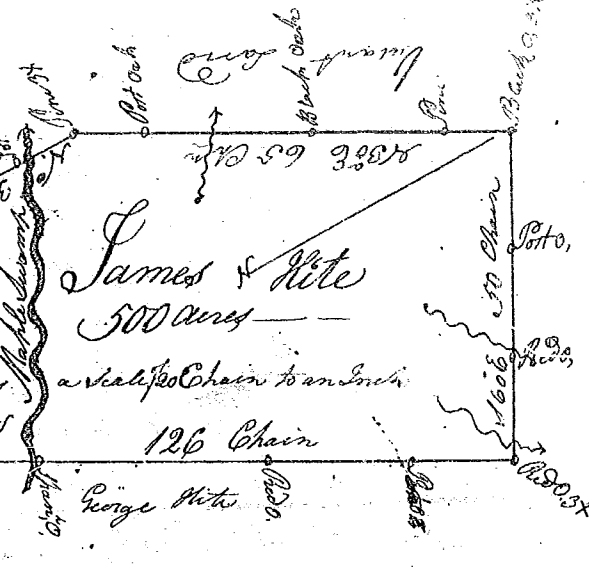


State of South Carolina Ninety six District

East of the ancient Boundary line  
Pursuant to a warrant from John Thomas Esq<sup>r</sup>  
Commissioner of Locations bearing date the 28<sup>th</sup>  
day of July 1784 I have admeasured & laid out  
unto the said William a tract of land containing  
two hundred and forty acres, lying on Dutchmans  
creek bounded by James Lancaster East by Capt  
North by John Shanky, West by Ralph Smith the  
North Creek & by the annexed plat  
Represents Survey the 20<sup>th</sup> day of Sept<sup>r</sup> 1784



State of South Carolina 96 District

On the East side of the ancient Boundary line  
Pursuant to a warrant from John Thomas Esq<sup>r</sup>  
Commissioner of Locations dated the 5<sup>th</sup> day Sept<sup>r</sup> 1784  
I have admeasured & laid out unto Thomas Haslow  
a tract of land two hundred acres lying on Middle  
Creek bounded on all sides on Vacant Land  
as the annexed plat represents Survey the 28<sup>th</sup>  
day of Sept<sup>r</sup> 1784  
Recorded the 19<sup>th</sup> day of Oct<sup>r</sup> 1784

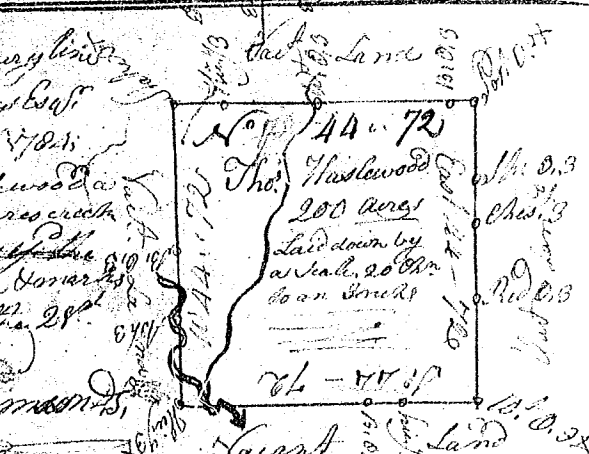

State of South Carolina 96 District, East of the ancient Boundary

Pursuant to a warrant from John Thomas Esq<sup>r</sup> Commis<sup>r</sup>  
of Locations for the new Salva... dated 28<sup>th</sup> July 1784 I have ad  
measured & laid out unto Samuel Lancaster a tract of land  
containing 140 acres, lying on the branches of Sugar  
creek & Dutchmans creek bounded by James Ben  
metland all other sides Vac<sup>t</sup> & hath such shape  
and marks as the annexed plat represents Survey the  
20<sup>th</sup> Sept<sup>r</sup> 1784  
Recorded the 19<sup>th</sup> Oct<sup>r</sup> 1784

