



State of South Carolina 1784

Pursuant to a warrant from John Thomas Esq. Commissioner of Locations, I have admeasured and laid out unto Abel Pearson a tract of one hundred & ninety acres of land, situate in Ninety six District below the line, & on waters Enoree River bounding N.W. on Thomas Hill & Robert Wething on Vaquent land on N.E. on John Deacons all other sides Vacant & hath shape & marks as the annexed plat represents, done the 20th day of September 1784. Robt. Glendon D. S. Recorded the 4th Nov. 1784 Deliv. to Abel Pearson

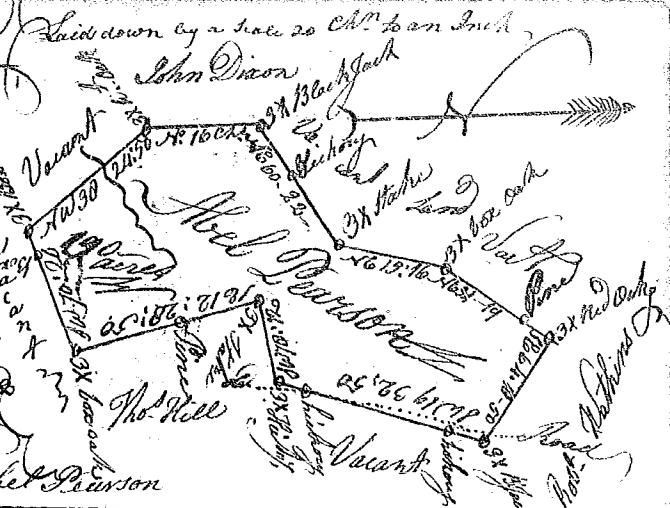

State of South Carolina

Pursuant to a warrant from John Thomas Esq. Commissioner of Locations I have admeasured and laid out unto Abel Pearson a tract of one hundred and forty one acres of land situate in Ninety six dist. on the waters of Duncan's Creek and Enoree River, Bounding W. on land unknown, N. on Abel Pearson's land S.E. on Vacant land & N.E. on Edwards, and hath shape and marks as the above Plat Represents, surveyed 21 sept. 1784 Robt. Glendon D. S. Recorded 14th Nov. 1784.

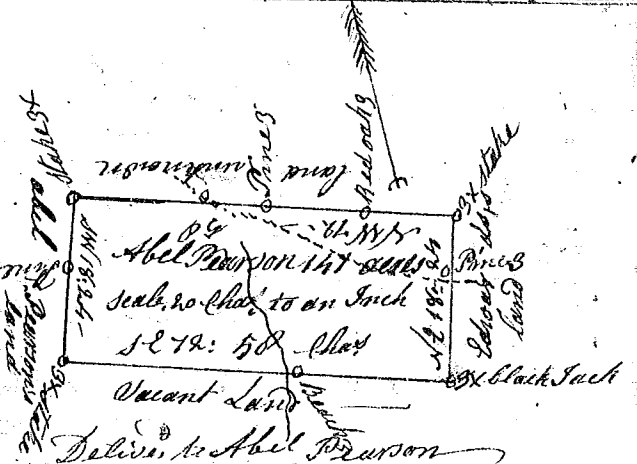

State of South Carolina

Pursuant to a warrant from John Thomas Esq. Commissioner of Locations in Ninety six District N.E. Saluda River dated 19th Aug. 1784 I have admeasured and laid out unto William Rice a tract of Land containing one hundred and fifty acres on Todd's Creek a branch of little river below the Indian Boundary. Bounded N.E. on the edge of land N.W. on Holt Taylor's land and S.W. on Elanor Speer's land, all other sides on Vacant land, and hath shape and marks as the annexed plat represents. Surveyed the 11th day Sept. 1784 Robt. Hanna D. S. Recorded 14th Nov. 1784.



State of South Carolina

Pursuant to a warrant from John Thomas Esq. Commissioner of Locations in 96 District No. of Saluda River dated 30th Aug. 1784 I have admeasured and laid out unto William Simpson a tract of Land containing one hundred and fifteen acres, on a small branch of Indian Creek below the Indian boundary. Bounded S. on land claimed by Robt. Brooks W. on Dr. Loffhain's land S.E. and N.E. on land claimed by Ansel Beaudin and W. Spikeman, all other sides on Vacant land, and hath such shape and marks as the annexed Plat Represents. Surveyed the 19th Sept. 1784 Robt. Hanna D. S. Recorded 14th Nov. 1784

