

State of South Carolina

Pursuant to a warrant to a warrant from
 John Thomas Esq. Comr. of Locations dated the
 19th of Aug. 1784. I have measured & laid
 out unto Thomas Morrow a Tract of two
 hundred Acres of land, Situate in Ninety
 six District East of the Ancient Boundary
 on Holston Creek of South, Sholet River.
 Bounding on all sides by Vacant Land
 and hath such Shape & marks as the above
 Plat Represents. Survey^d this 23rd Sept. 1784

Recorded the 14th of Dec. 1784

Wm. Benson D^y




State of South Carolina Pursuant to a warrant from

John Thomas Esq. Commissioner of Locations dated the 26th of
 August 1784 I have measured & laid out unto Thomas
 Morrow a Tract of one hundred acres of land Situate in
 96 Dis. East of the Ancient Boundary line on Painter Creek
 of Enoree River. Bounding to the N of land laid out Woodard
 all other sides Vacant Land. Hath such Shape & marks as
 the above Plat Represents. Survey^d this 20th Oct. 1784

Recorded the 14th Dec. 1784

Wm. Benson D^y

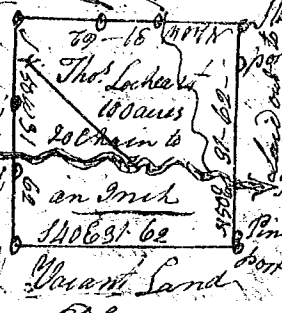


State of South Carolina Pursuant to a warrant

from John Thomas Esq. Commissioner of Locations
 dated the 1st of August 1784 I have measured & laid
 out unto Rhemata Withins a Tract of one hundred
 and four acres of land Situate in Ninety six District
 East of the Ancient Boundary on the Riverbank of
 Sawpost Creek. Bounding to the NW of land laid
 out to John Golegilly NE of land Giles Connors land &
 all other sides Vacant Land, & hath such Shape & marks as
 the above Plat Represents. Survey^d this 7th of Sept. 1784

Recorded the 14th Dec. 1784

Wm. Benson D^y

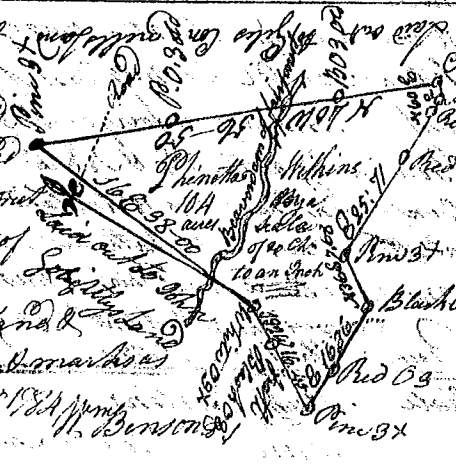

State of Carolina

Pursuant to a warrant
 from John Thomas Esq.
 Comr. of Locations dated
 the 7th of Sept. 1784
 I have measured &
 laid out unto

William Ford a Tract
 of two hundred & forty seven acres of land Situate
 in 96 Dis. East of the Ancient Boundary on the
 branches of North Tugar River. Bounding to the NE & SE
 of John Parkers Land, NW to Selmers West to Davids Land
 Esq. NW to Sawrons, all other sides Vacant Land and hath such Shape
 and marks as the above Plat Represents. Survey^d this 1st Oct. 1784

Recorded the 14th Dec. 1784

Wm. Benson D^y

