



State of South Carolina
 Pursuant to a warrant from John Tho
 mas Esq. Commissioner of Locations I have adme
 -measured & laid out unto Hugh Nelson a
 Tract of One Hundred acres of land situate in
 Ninety six District on the waters of Browns Creek
 Bounding N. by on land said but all other
 sides on land laid out & vacant Land, & hath
 such shape & marks as the annexed plat here
 = presents. Surveyed the 1st day of Jan^y 1785
 Recorded the 4th Jan^y 1785
 Delivered to Hugh Nelson

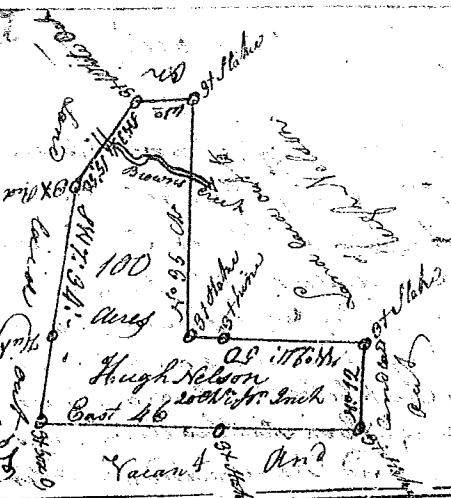

State of South Carolina
 Pursuant to a Warrant from John Thomas
 Esq. Commissioner of Locations I have
 admeasured & laid out unto Benjamin Gre
 -gory a Tract of two Hundred acres of land situate
 -situate in 96 District on the waters of Browns
 creek Bounding N. by on land laid
 out to Christopher Hemmons all
 other sides on land laid out &
 Vacant Land & hath such shape
 and marks as the annexed plat
 = presents. Surveyed the 1st Jan^y 1785
 Recorded the 4th Jan^y 1785
 Delivered to John Gregory

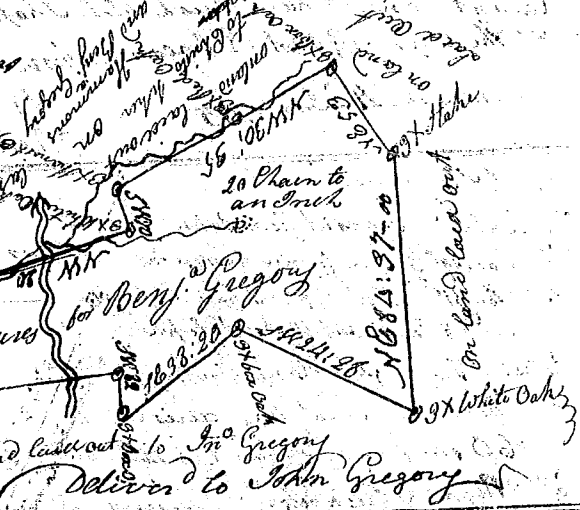

State of Carolina
 Pursuant to a warrant to a warrant from
 John Thomas Esq. Com^r Locations I have admeasured
 & laid out unto Isaac Gregory a Tract of one hundred
 and three acres of land situate in 96 District on the
 waters of Browns Creek Bounding N. by on land laid
 out to Benjamin all other sides on Vacant Land &
 Land laid out & hath such shape & marks as the
 annexed plat represents Surveyed the 22nd Dec^r 1784
 Recorded the 4th Jan^y 1785
 Delivered to John Gregory



State of South Carolina
 Pursuant to a warrant from John Thomas
 Esq. Com^r Loc. dated the 2nd Oct^r 1784. I have admea
 -sured & laid out unto John Camron a Tract
 Land containing 225 acres, situate in 96 District
 on Neaburns Creek Below the ancient Boundary
 line, Bounded N. by on Jonathan Downs Esq. Land East
 on William Williams land & on Maj^r Wm. M^r Lewis
 Sr on James Cunningsham's land and hath
 such shape and marks as the annexed plat
 = presents. Surveyed the 6th Oct^r 1784
 Recorded the 4th Jan^y 1785
 Delivered to John Camron

