


State of South Carolina Pursuant to a Warrant from John Thomas Esq. Com. of Locations in 96 District North Side of the River bearing date the 15th of August 1784. I have admeasured & laid out unto Michael Purkle a tract of land containing two hundred acres on Needy River West of the old Indian Boundary. Bounding NW part 60° 10' on land laid out to the said Michael Purkle and part on Vacant Land & hath such shape and marks as the annexed plat represents Survey the 8th day of Sept. 1784. Wm. Glenn D.S. Recorded the 4th Jan^y 1785.




Delivered to John Carnochan

State of South Carolina, pursuant to a Warrant from John Thomas Esq. Com. Locs, I have admeasured & laid out unto Mary Caldwell a tract 56 1/2 acres of land, situate in 96 District below the line, on waters of Enoree River. Bounding NW on land laid out to J. Caldwell & W on John Caldwell's & on John Clarks & on Charles's lands & hath such shape & marks as the annexed plat represents Survey the 21st day of Nov. 1784. Wm. Glenn D.S. Recorded the 5th day of January 1785.

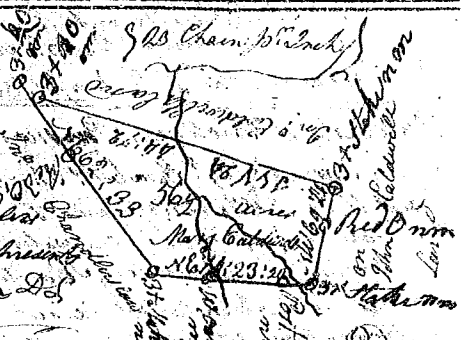

State of S. Carolina Pursuant to a Warrant from John Thomas Esq. Com. Loc. I have admeasured & laid out unto Mary Caldwell a tract of one hundred & fifty acres of land, situate in 96 District below the line on S. side of Enoree River. Bounding NW on land laid out to Thos. Willoughby & on Major Gordon's on Major Gordon's on the other side of Enoree River & hath such shape & marks as the annexed plat represents Survey the 1st Nov. 1784. Wm. Glenn D.S. Recorded the 5th Jan^y 1785.

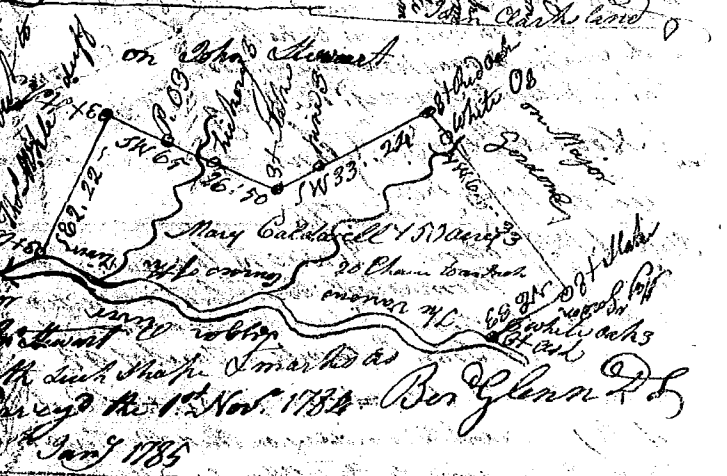

State of S. Carolina Pursuant to a Warrant from John Thomas Esq. Com. Loc. I have admeasured & laid out unto Wm. Cureton Junr a tract of 117 1/2 acres of land, situate in 96 District on the West side of Enoree below the line Bounding NW on Joel Chandler's & Ferguson & Aubry Nolins lands NW on J. Caldwell Aubry Nolin Wm Hill & Wm Gordons lands NE on J. Caldwell's John Clarks & Joel Chandlers lands SE on Wm Gordons & J. Caldwell's lands and hath such shape & marks as the annexed plat represents Survey the 5th Dec. 1784. Wm. Glenn D.S. Recorded the 5th Jan^y 1785.

