



State of Carolina Pursuant to a (338)
 Warrant from John Thomas Esq. in
 96 District N. Carolina. Dated the
 17th Oct. 1787. I have admeasured and
 laid out unto Thomas Maxwell a tract
 of 205 acres of land. Situate in said
 District in Greenville County on both
 sides Green Creek of South Carolina
 River: Near the Hogback Mountain
 Bounding by lines run S. E. & S. W. by
 by land Surveyed for Duncan Campbell
 all other sides vacant and both
 sides from & marks as the above plat
 represents. Surveyed the 18th Oct. 1787
 Recorded the 25th Feb. 1788

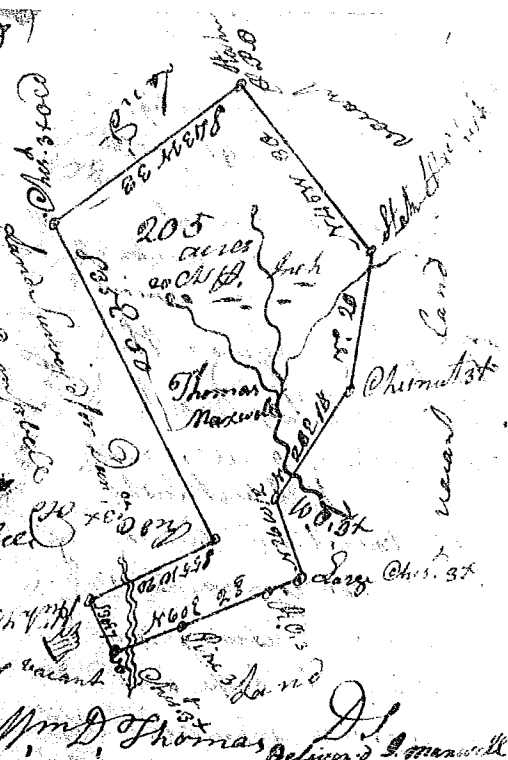

State of Carolina Pursuant to a warrant
 from John Thomas Esq. Commissioner
 of Saluda River: I have admeasured
 & laid out unto William Turner
 a tract of 260 acres of land
 situated below the outlet
 bounding line on both sides of South
 Branch & Middle Green branch of
 Saluda fork of the South River
 marks and bounding as the
 above plat represents
 Surveyed the 15th Oct. 1787
 Recorded 25th Feb. 1788



State of Carolina Pursuant to a warrant from
 John Thomas Esq. Commissioner in 96 District
 of Saluda Dated the 17th Oct. 1787. I have
 admeasured & laid out unto Thomas Theinade
 a tract of 89 acres of land. Situate in the S.
 District on the branch of Ruddy River
 bounding on a line running N. E. by land Survey
 or Pat. Candrick on land Survey for property
 of Robert Ramsey of both sides from & marks
 as the above plat represents.
 Surveyed the 17th Oct. 1787

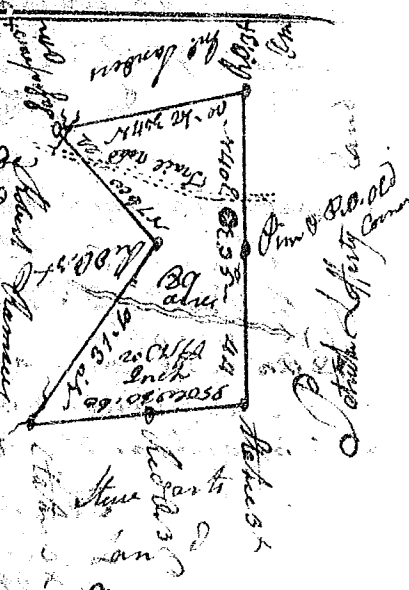

Recorded the 25th Feb. 1788