

(6)

1785

N 86 W 297 Chas

Wade Hampton

8840 acres

scale, 40 Chains to an Inch


State of S<sup>c</sup> Carolina Pursuant to a warrant to  
 me Directed from John Thomas Esq. Dated 26<sup>th</sup>  
 Oct<sup>r</sup> 1785, I have Measured, and laid out unto  
 a tract of land containing 8840 acres, situated on  
 both sides of Tennessee river, beginning at the  
 Mouth of Judasfriend Creek, bounded W. by S.  
 River, and on every side by Vacant land,  
 and hath such Courses and Marks as this  
 Plat represents,

Survey<sup>d</sup> 19<sup>th</sup> Dec<sup>r</sup> 1785

by Rich. Harrison D<sup>c</sup>

Recorded 25<sup>th</sup> Febr<sup>y</sup> 1786

S 30 W 345 Chas

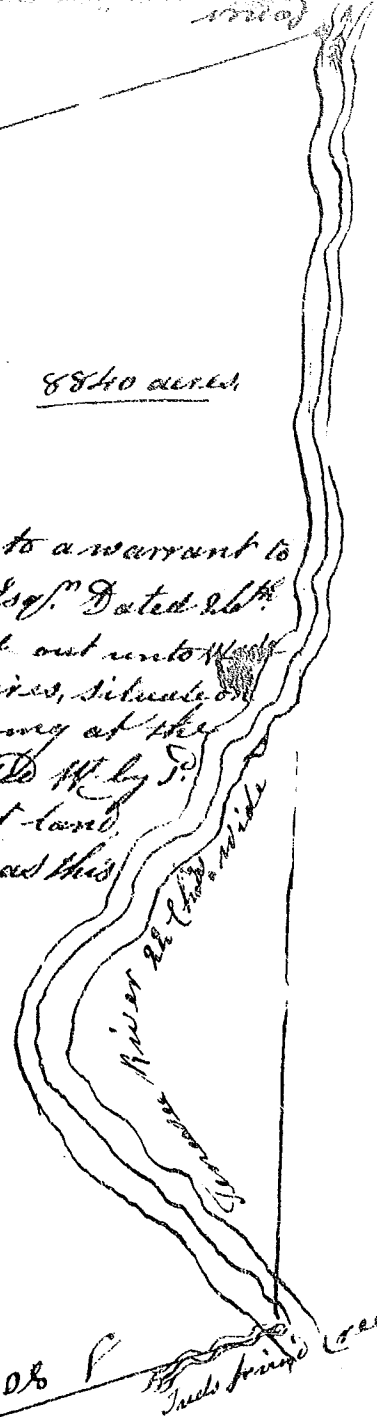

map 468 of 08 P

Judasfriend Creek

Corner