


State of South Carolina (83)

Pursuant to a warrant from John Thomas Esq. C. L. for 96 District No. of Saluda river, I have admeasured & laid out unto James Blasingame a Tract of one Hundred and Eighty Seven acres of Land, in said district on a creek called Tachary fork a branch of Needy River, and hath such form, Marks, luthings and boundings as the above Plat Represents.

Certified to Oct. 17 1786.
Recorded 21. Oct. 1786.

(By J. Lewis D. S.)

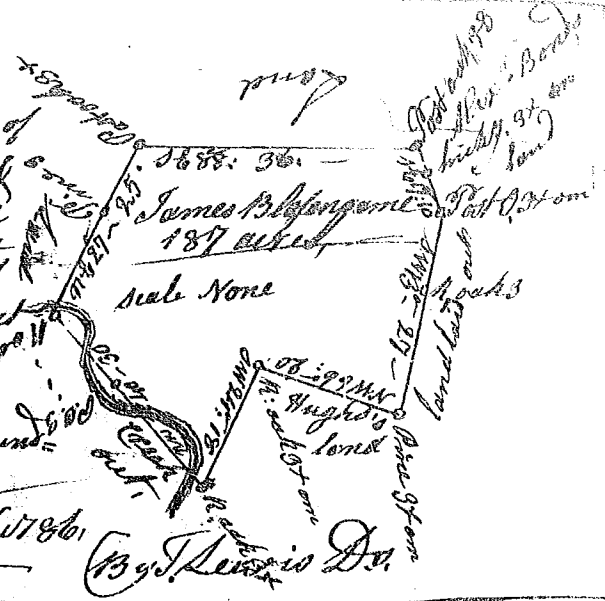

Lawrence County.

Pursuant to a Warrant from John Thomas Esq. C. L. Dated the 21st Oct. 1786: I have Admeasured & laid out unto John Rodgers (son of Andrew) a Tract of One Hundred and Seventy Acres of Land, on a branch of Duncans Creek the Waters of broad River. Bounding S.W. on Gilbert McNeary & Alex. McNeary, S. on said Land E. on John Harvey, below the Ancient Boundary, & hath such form & marks as the Above plat Represents.

Surveyed this 4th Oct. 1786. J. John Rodgers D. S.
Recorded the 23rd Oct. 1786. D. W. Rodgers

