(164)

North Carolina. Pursuant to a warrant from John Thomas Esq. C.C. I have admeasured & laid out unto William Hamilton a tract of 215 Acres of Land. On a branch of Kings Creek in Newberry County having such & no marks Buttings & Bounsings as the Annexed Plat Represents Survey'd the 28th Aug.t 1786

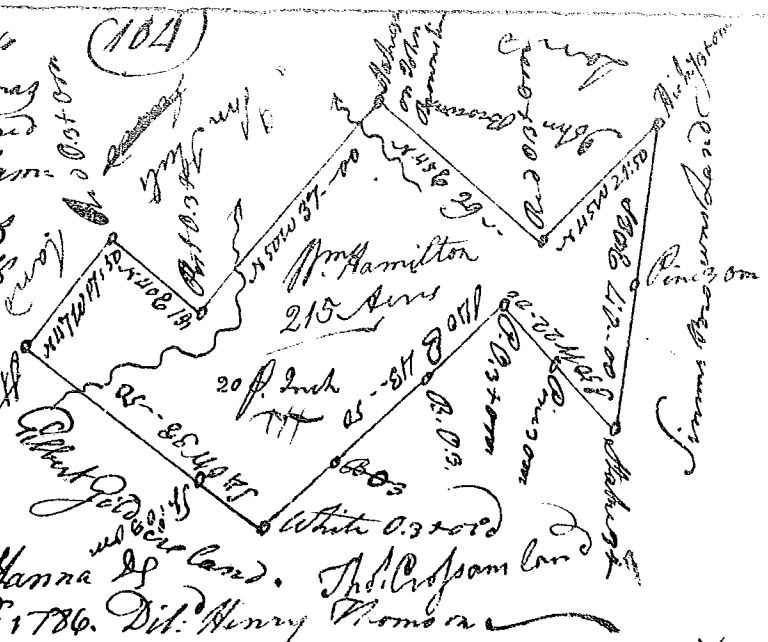

Recorded the 11th Nov.r 1786. Dil: Henry Thomson

State of N. Carolina } Pursuant to a warrant from John Thomas Esq.r Comm.r Locations No. Saluda. I have admeasured & laid out unto William Hamilton a tract of One Hundred & Thirty five Acres of land On a small branch in Newberry County. Having such shape & land marks Buttings & Bounsings as the annexed Plat Represents. Surveyed the 29. Aug.t 1786

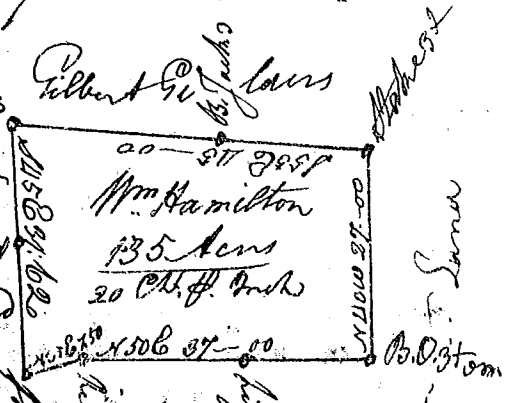

Recorded this 11th Nov.r 1786 D.d Henry Thomson

State of south Carolina 96 District Pursuant to a warrant from John Thomas Esq.r Comm.r of location Dated 3. June 1786. I have admeasured and laid out unto Joel Hembry a tract of seventy Eight acres of land on the N.th side of Tygar river, bound So by Tygar river, E.t by Timothy Cotney's land, W by John Campbells land, and hath such shape and Marks as the above Plat Represents, Survey'd 30th June 1786

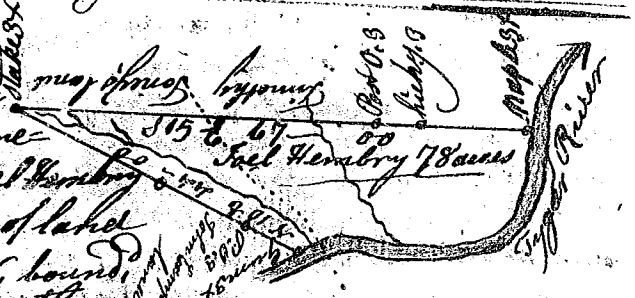

Recorded 14th Nov.r 1786.

State of.to Carolina 96 District } Pursuant to a warrant from John Thomas Esq.r Comm.r of locations Dated this 3. June 1786. I have admeasured and laid out unto Joel Hembry a tract of 60 acres of land on the N.th side of Tygar river, Including 4 Islands in said River, bounded E.t by vacant land N.th by John Asiel's land, So.th by Tygar river, and hath such shape and Marks as the above Plat represents, Survey'd 30th June 1786

Andrew Thomson D.s

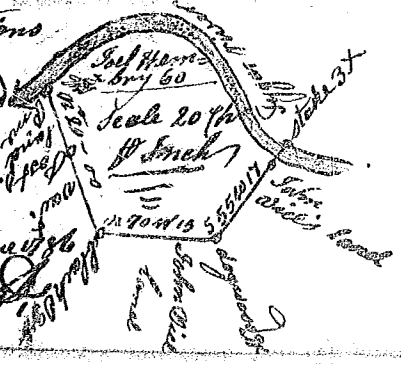

Recorded 14th Nov.r 1786

Andw Thomson D.s