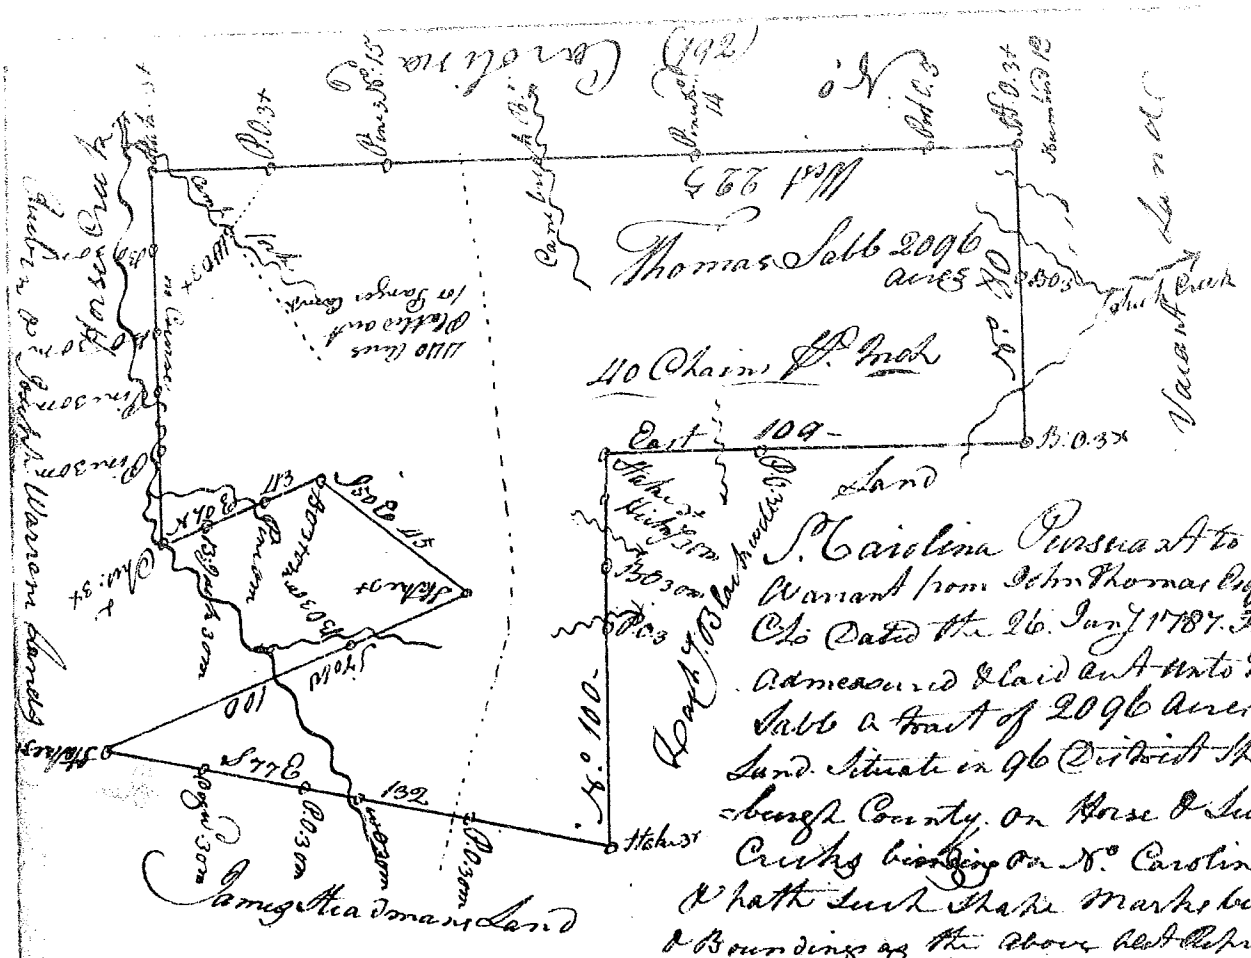
Thomas Sabb 2096 acres
East 109
Land
Hickory
Poplar
Ash
Gum
