
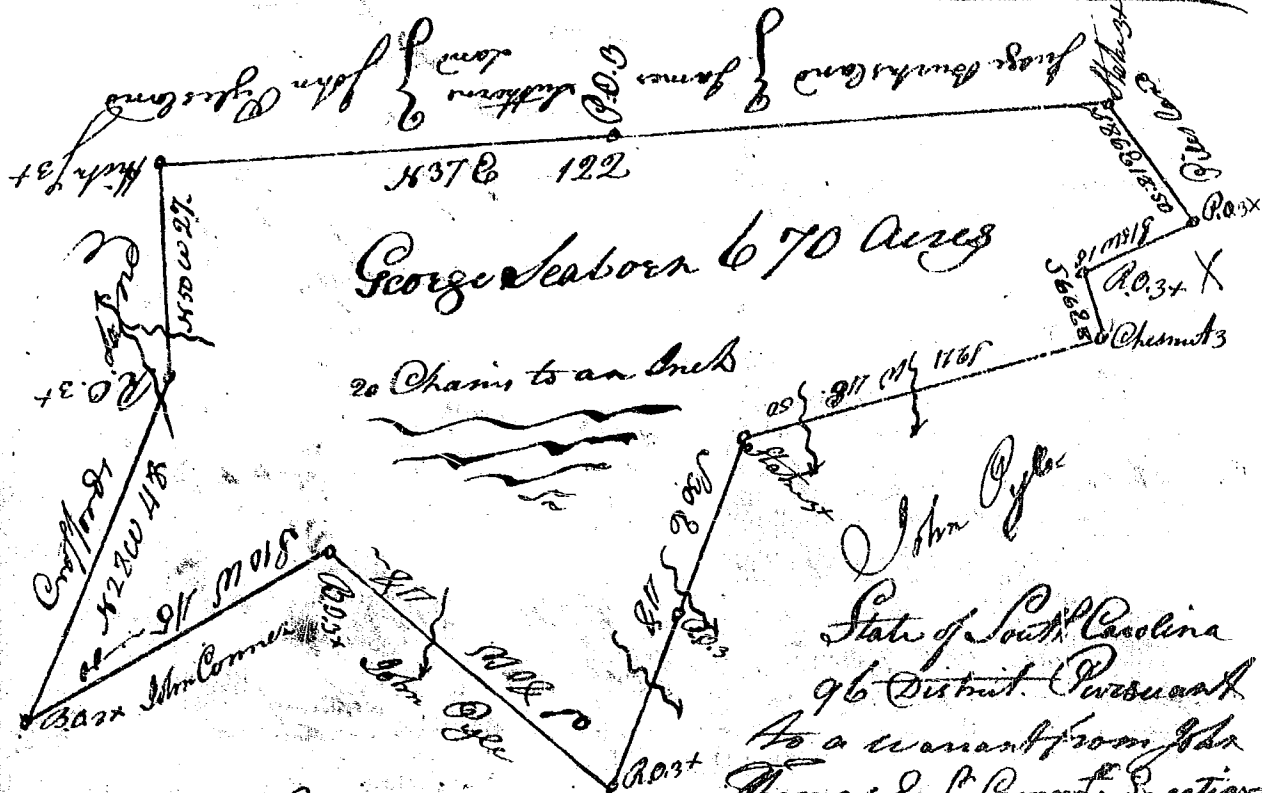


State of South Carolina  
 Pursuant to a warrant from  
 John Thomas Esq. of locations  
 N<sup>o</sup>. Saluda, I have surveyed  
 and laid out unto John  
 James a tract of two  
 hundred and sixty acres  
 of land on Soffley's  
 Branch in Newberry  
 County, Having  
 such shape, marks,  
 buttresses & bounding  
 as the above plat  
 represents. Surveyed  
 & Surveyed by D. Noot 1786

Recorded 8<sup>th</sup> Decr. 1786.

Robert Thomas Esq. Surveyor

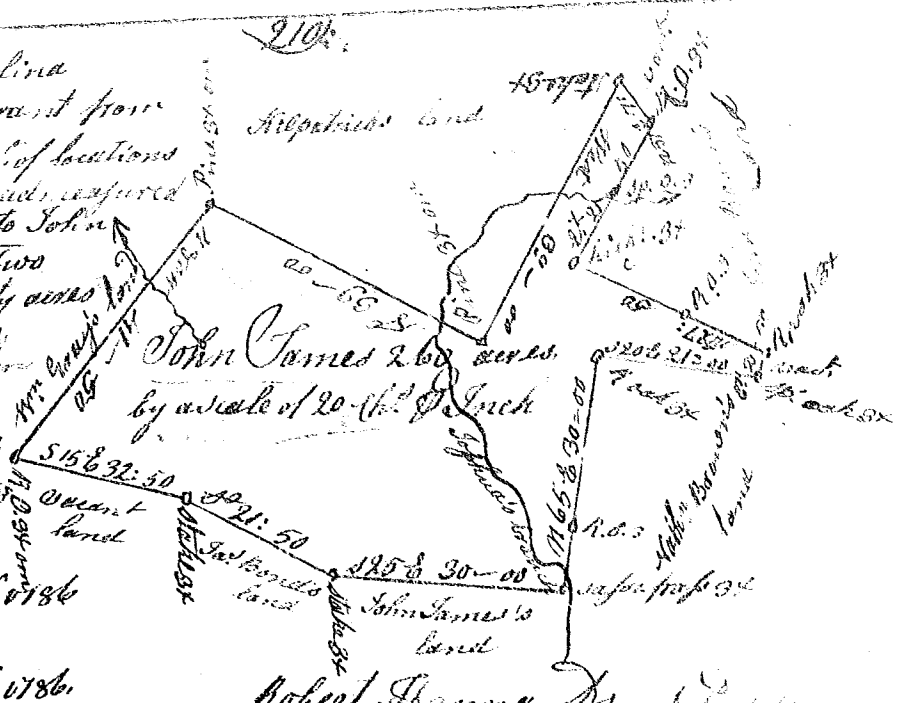

North of Saluda River: Dated 10<sup>th</sup> April 1787. I have assured  
 -sured and laid out unto George Seaborn a tract of six  
 hundred & seventy acres of land. Situate ~~in~~ above the  
 ancient boundary, on the head branches of the Ruddy fork  
 of Ruddy River, also including 2 small branches of the Golden  
 Prow. It has such shape marks and bounding as the above  
 plat represents. Surveyed the 30<sup>th</sup> Apr. 1787

Recorded 16<sup>th</sup> May 1787

James Seaborn Esq.