


Carolina (14)
 Pursuant to a warrant from
 W. L. G. Co. of the Dist. of Green
 dated the 7th June 1804 I have admeas-
 ured & laid out to Armond Gifson
 a tract of land conty 148 acres -
 Situate in y^e S^d Dist. on both sides
 the Checharoa fork of the said river
 including a small improvement by
 Mr. Stanford bounded all round
 that he surveyed the 8th June 1804



Recorded 17th July 1804 del. J. G.

W. L. G. Co.

Carolina
 Pursuant to a
 warrant from W. L. G. Co.
 Thomas G. bin the dist.
 of Green dated the 17th
 July 1804 I have
 admeasured & laid out
 unto Stephen Phillips
 a tract of land contain-
 ing 348 acres
 Situate in said Dist.
 on the head branches of
 the Checharoa fork of the
 Checharoa river including an im-
 provement claimed by
 Robert Cox bounded on
 all sides by Vacant Mountain and hath such
 marks as the above plat represents

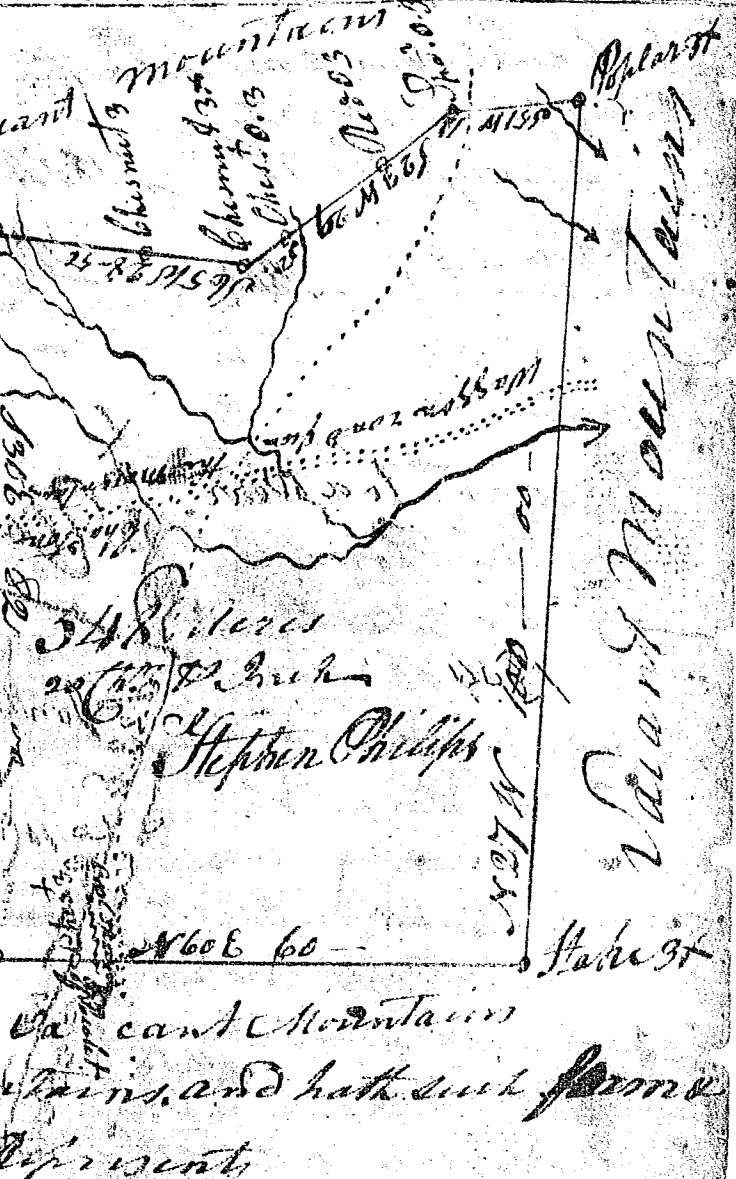

Surveyed the 18th July 1804

W. L. G. Co.