


EXHIBIT A

16-E-38

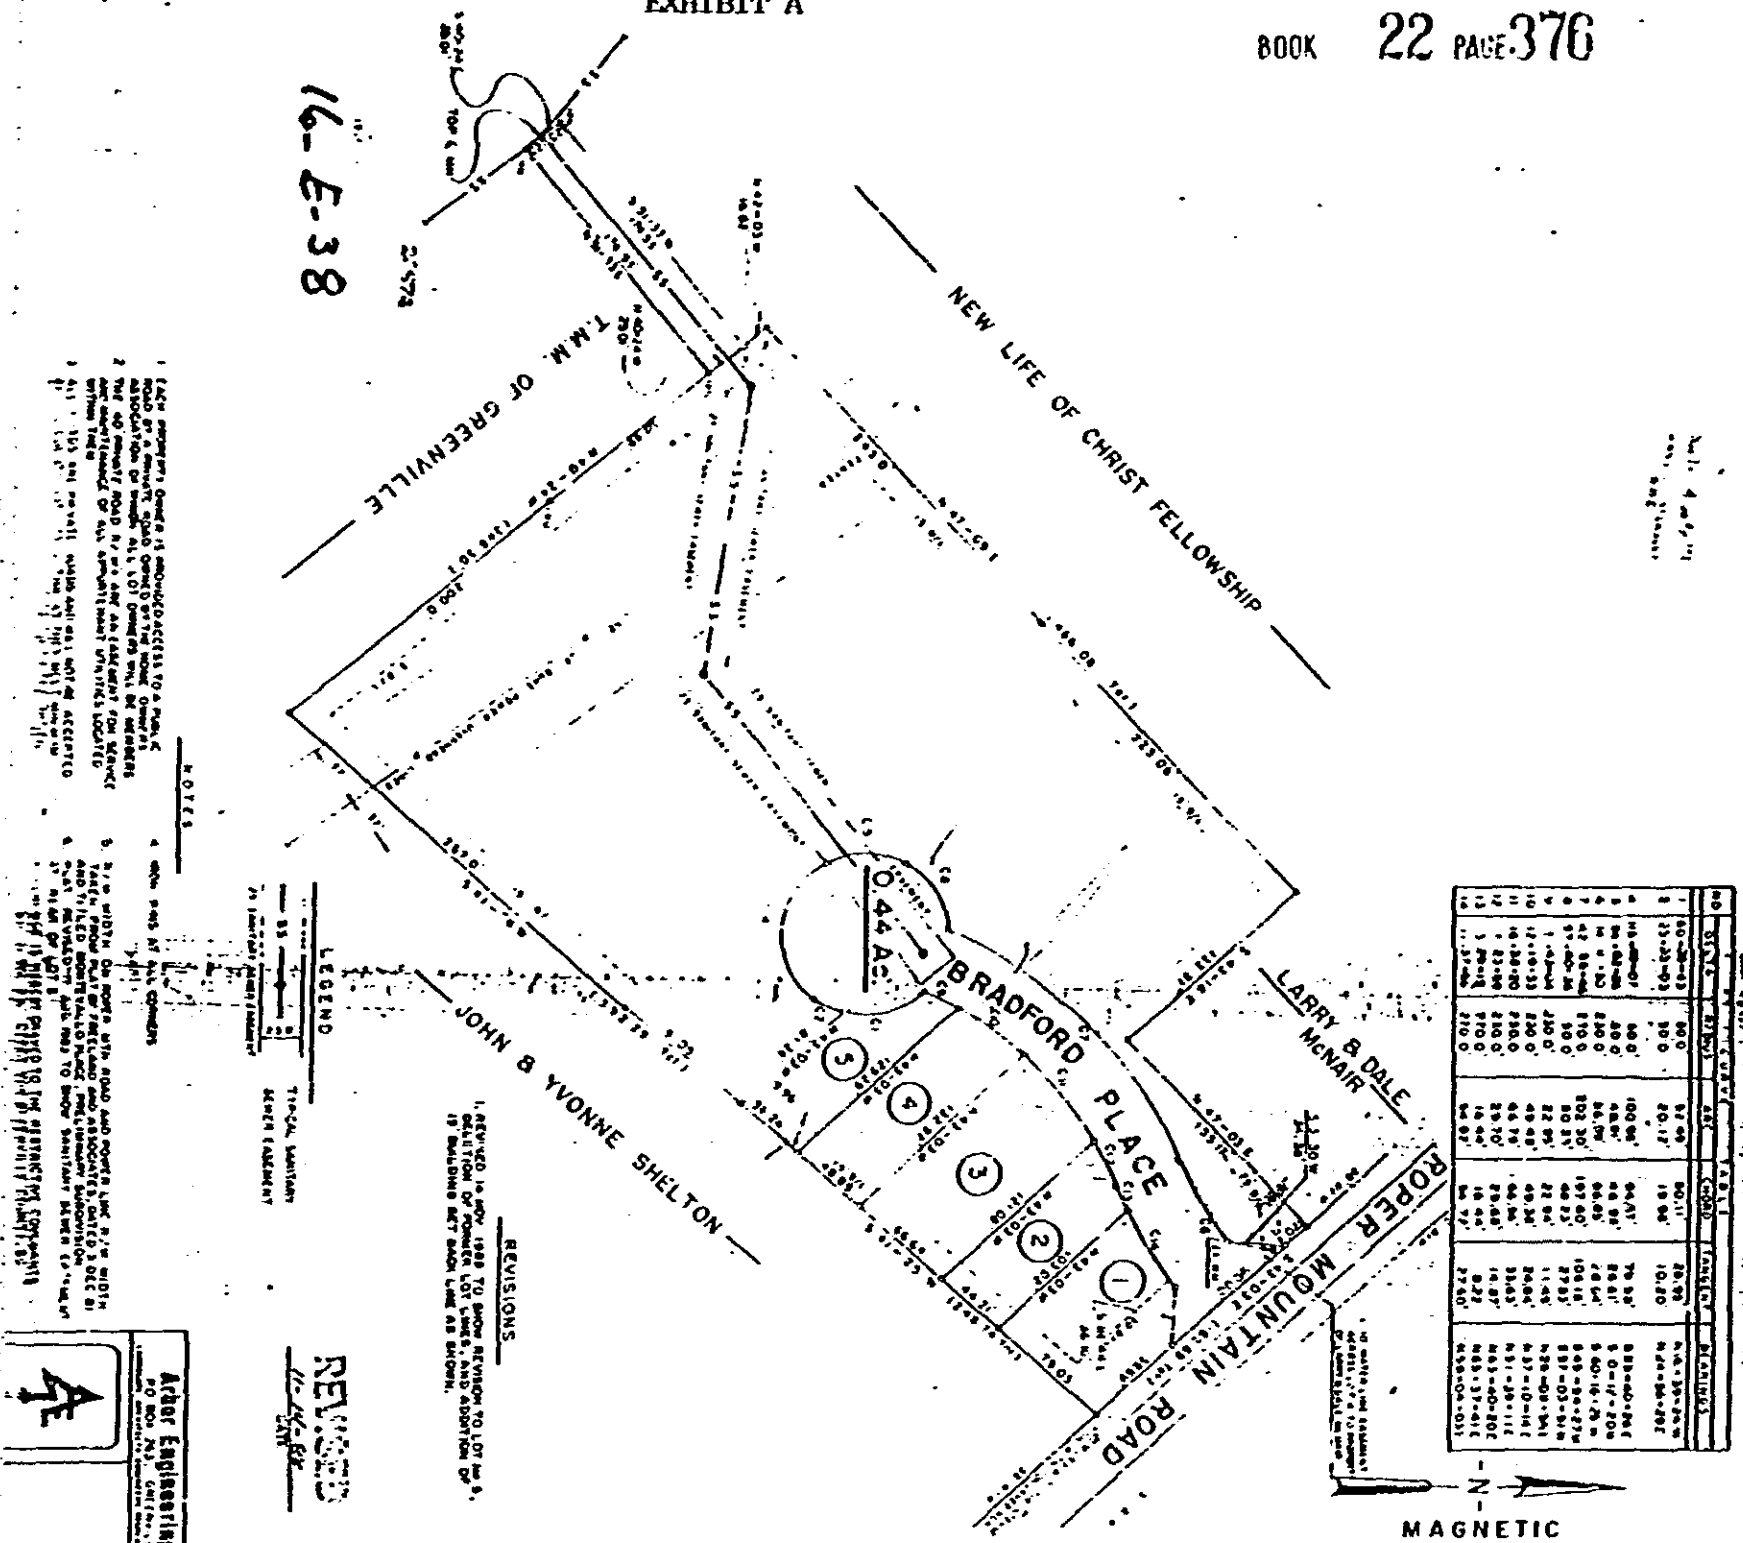

- NOTES:
ARTHUR ENGINEERING, INC.  








