


23443 Filed This 2 day of April 19 69

And Recorded in Vol. 4A Page 1163 at 12:36 P.M.

Ollie Farnsworth

Register Mesne Conveyance Greenville County, S. C.

WOODMONT CIRCLE

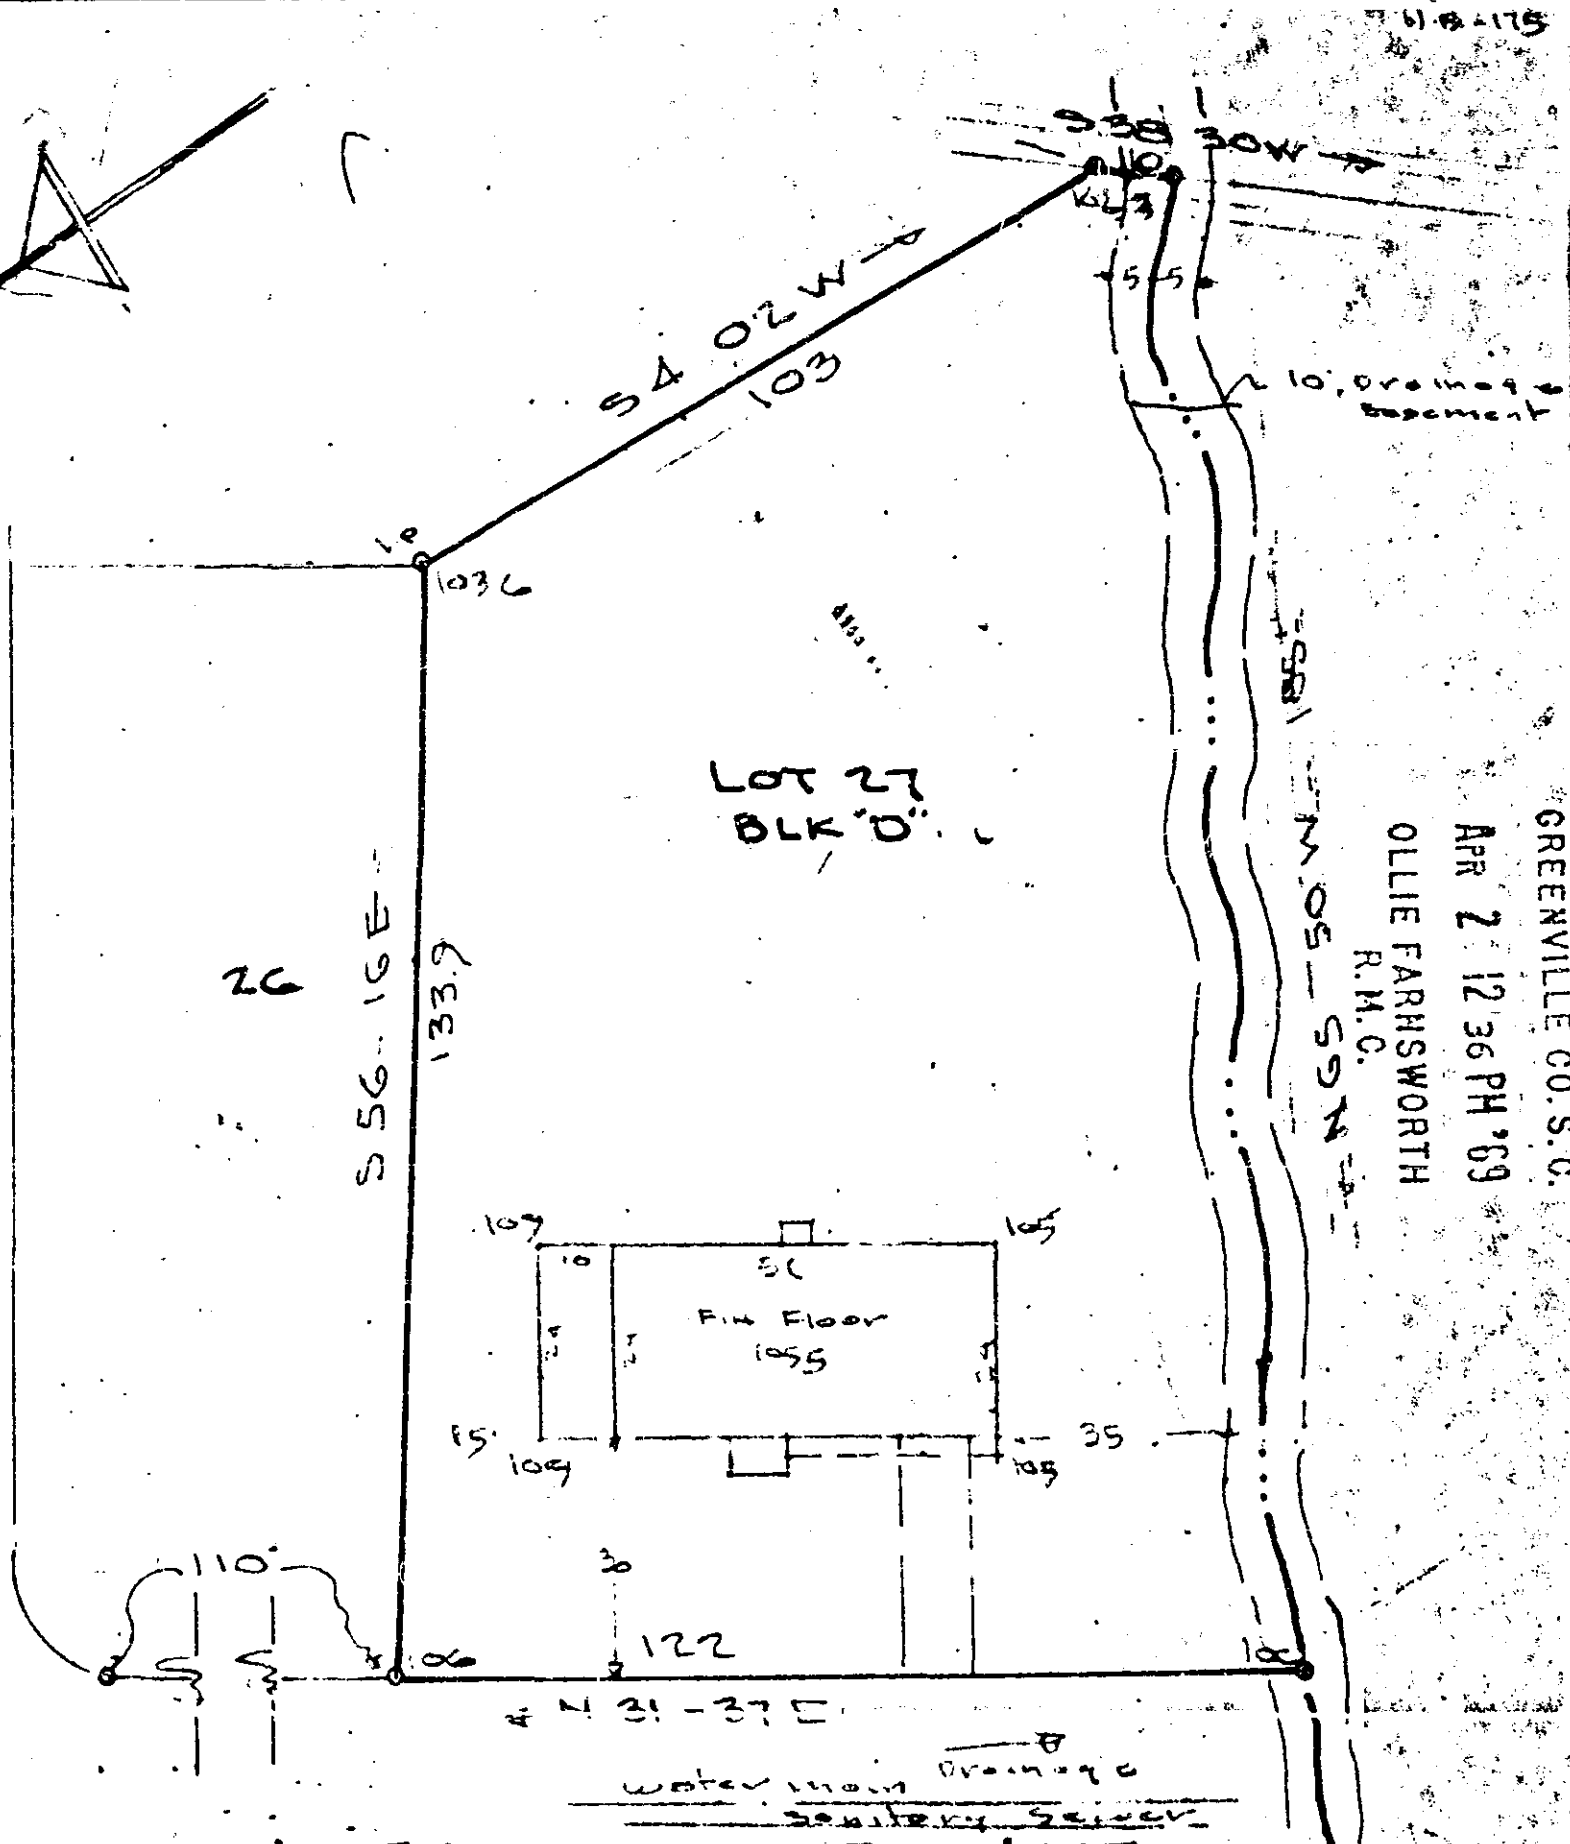

LOT 27
BLK 'D'

GREENVILLE CO. S.C.
APR 2 12 36 PM '69
OLLIE FARNSWORTH
R.M.C.

FAIRMONT AVE

FOUNDATION PLAN
LOT 27
BROOKFOREST

GREENVILLE COUNTY, S.C.

Scale 1/30 MAR 10 1969

4A-163
23143

JONES ENGINEERING SERVICE