



2 0 18

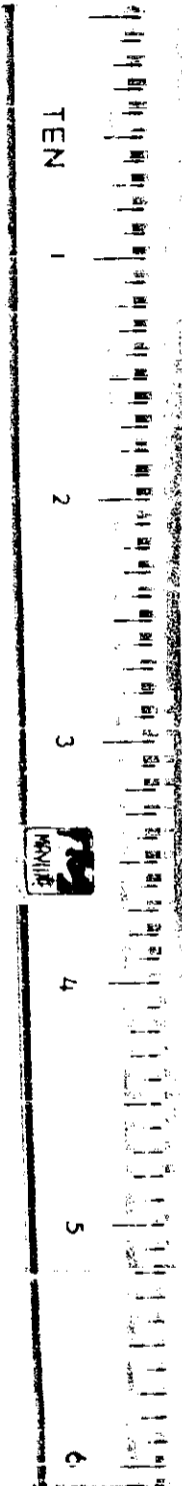

FORTNER ST.

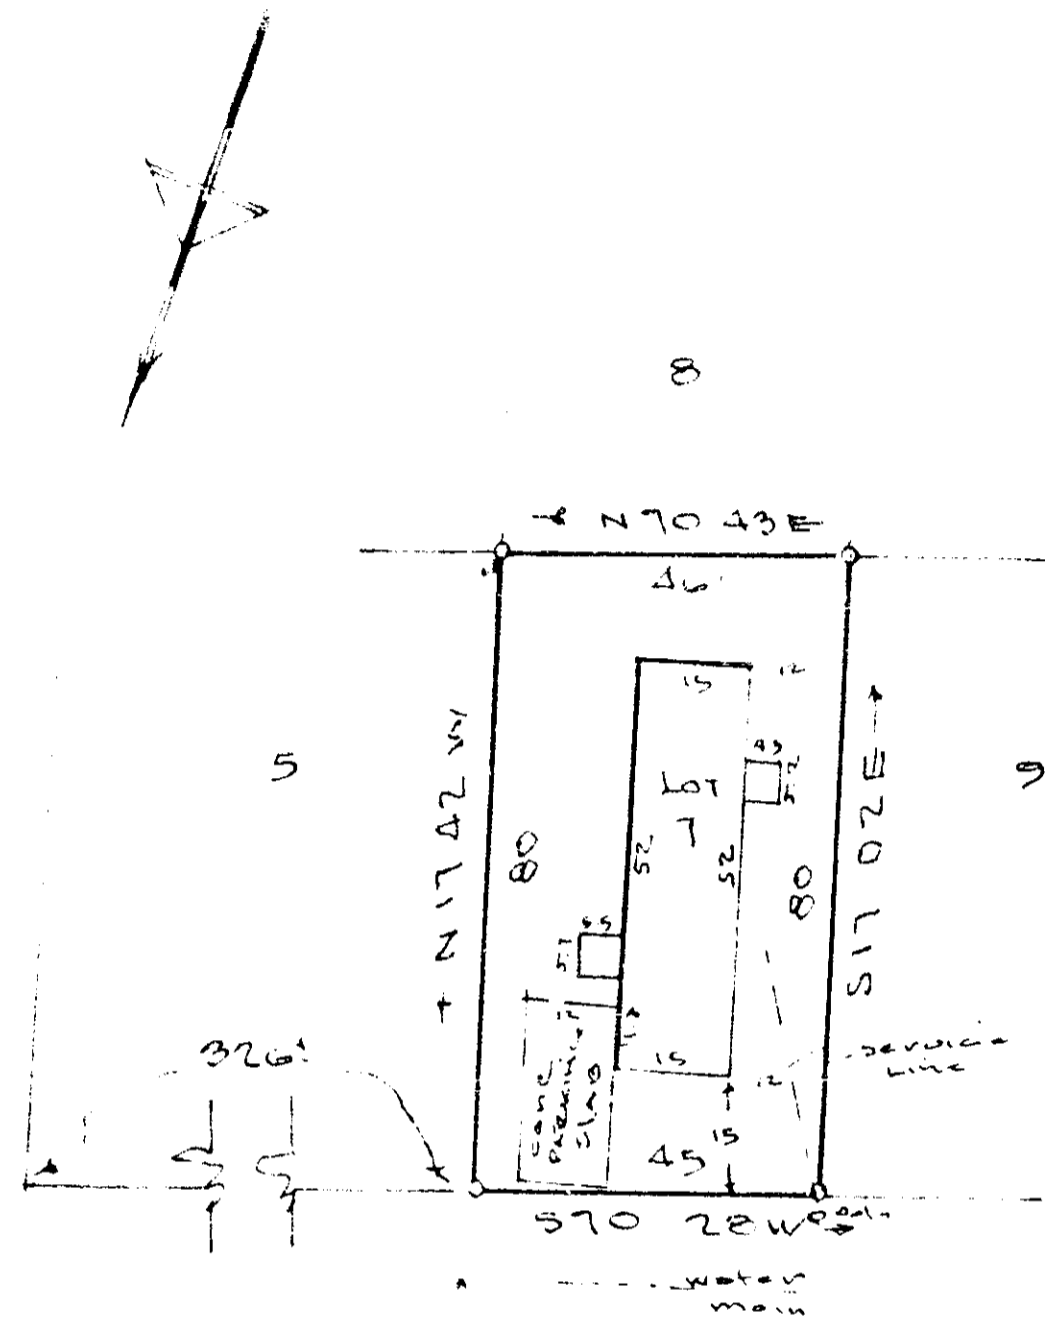

FILED
 GREENVILLE CO. S. C.
 MAY 30 10 23 AM '69
 OLLIE FARNSWORTH
 R.M.C.

50 FLORIDA AVE

28707

4 B-65

This is to certify that on the 27th day of MAY 1969, I surveyed the property shown on this plat, being LOT 1 WALTER B. READERS, recorded in P at Book 4 B of the R.M.C. Office for Greenville County, S. C., and that the property lines, walls and buildings are as shown hereon; that the buildings located on said lot do not encroach or project on adjacent streets or property; and that no adjacent buildings or walls encroach or project on said premises, and that no utility lines cross this property.

PROPERTY OF

BOB E. KING

GREENVILLE COUNTY, S. C.

[Signature] Scale 1"=30' MAY 27 1969
 Reg. Engineer No. 1144 S.C.
 JONES ENGINEERING SERVICES

BAD COPY