




July 23, 1969  
12:34 P.M. '69  
Ollie Farnsworth  
R.M.C.

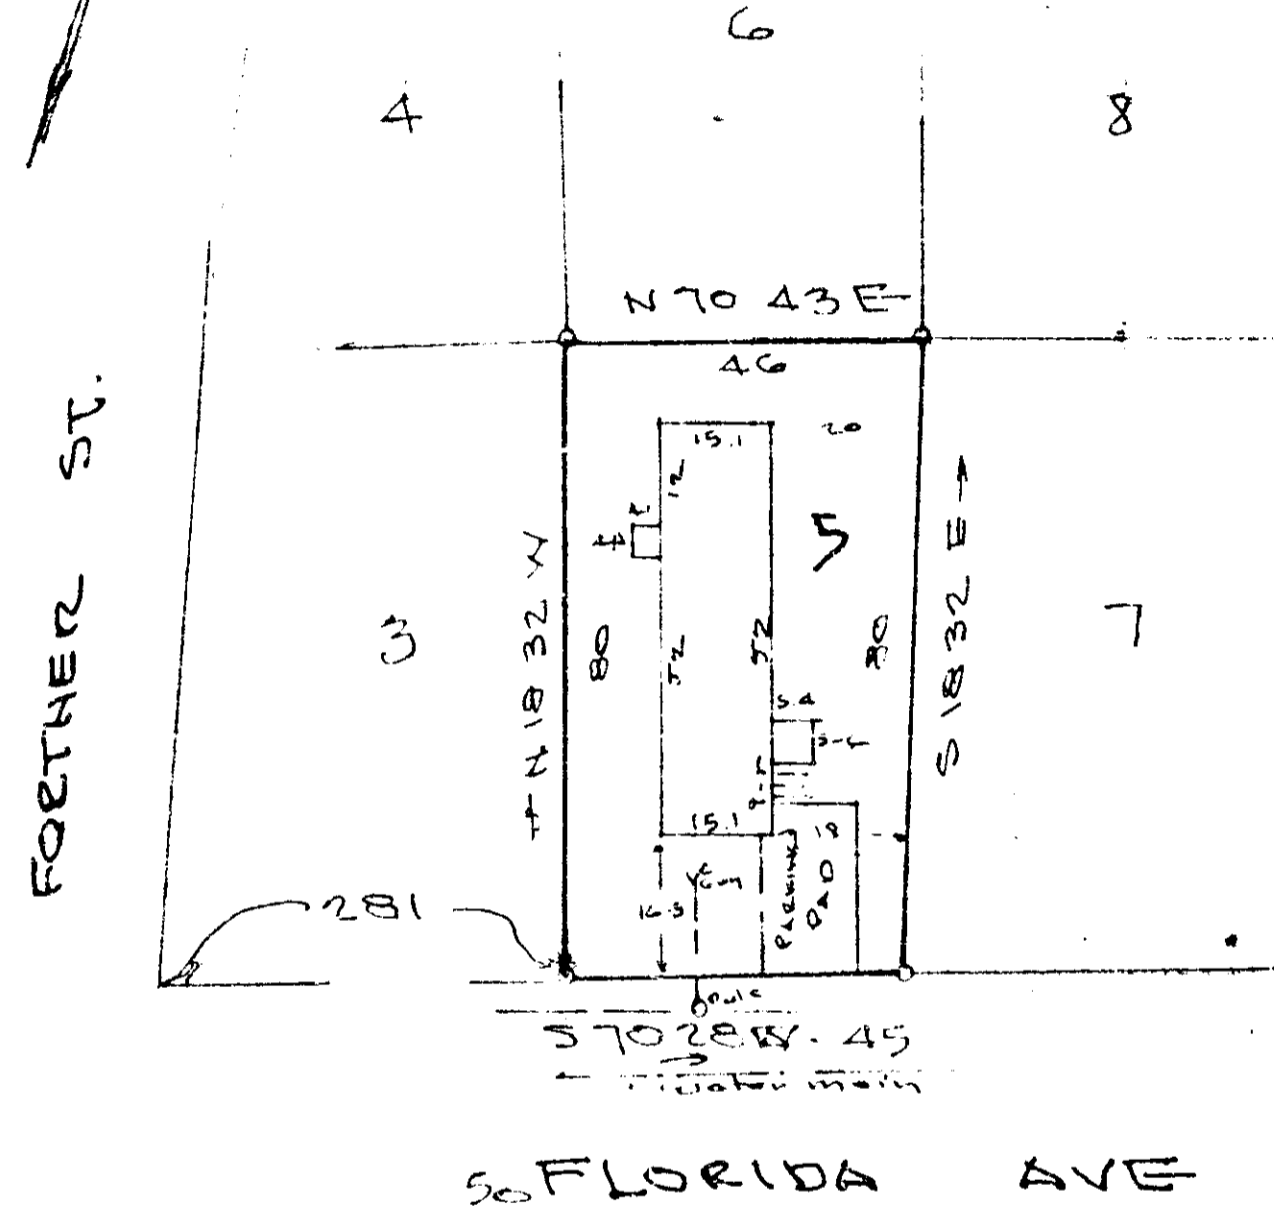

July 23, 1969  
1842  
4B - 165

PROPERTY OF

DANNY LEE HOWARD  
SHEILA B. HOWARD  
GREENVILLE COUNTY S.C.

This is to certify that on the 23 day of July 1969, I surveyed the property shown on this plat, being Lot 5, Walter B. Gignard's, recorded in Plat Book of the R.M.C. Office for Greenville County, S. C., and that the property lines, walls and buildings are as shown hereon; that the buildings located on said lot do not encroach or project on adjacent streets or property; and that no adjacent buildings or walls encroach or project on said premises, and that no utility lines cross this property.

Reg Engineer No. 1144 S.C.

YONES ENGINEERING SERVICES

