



#2793 Filed This 4 day of Aug. 1969

And Recorded in Vol. 4 B Page 177 at 3:12 P.M.

Ollie Farnsworth  
Register Mesne Conveyance Greenville County, S. C.

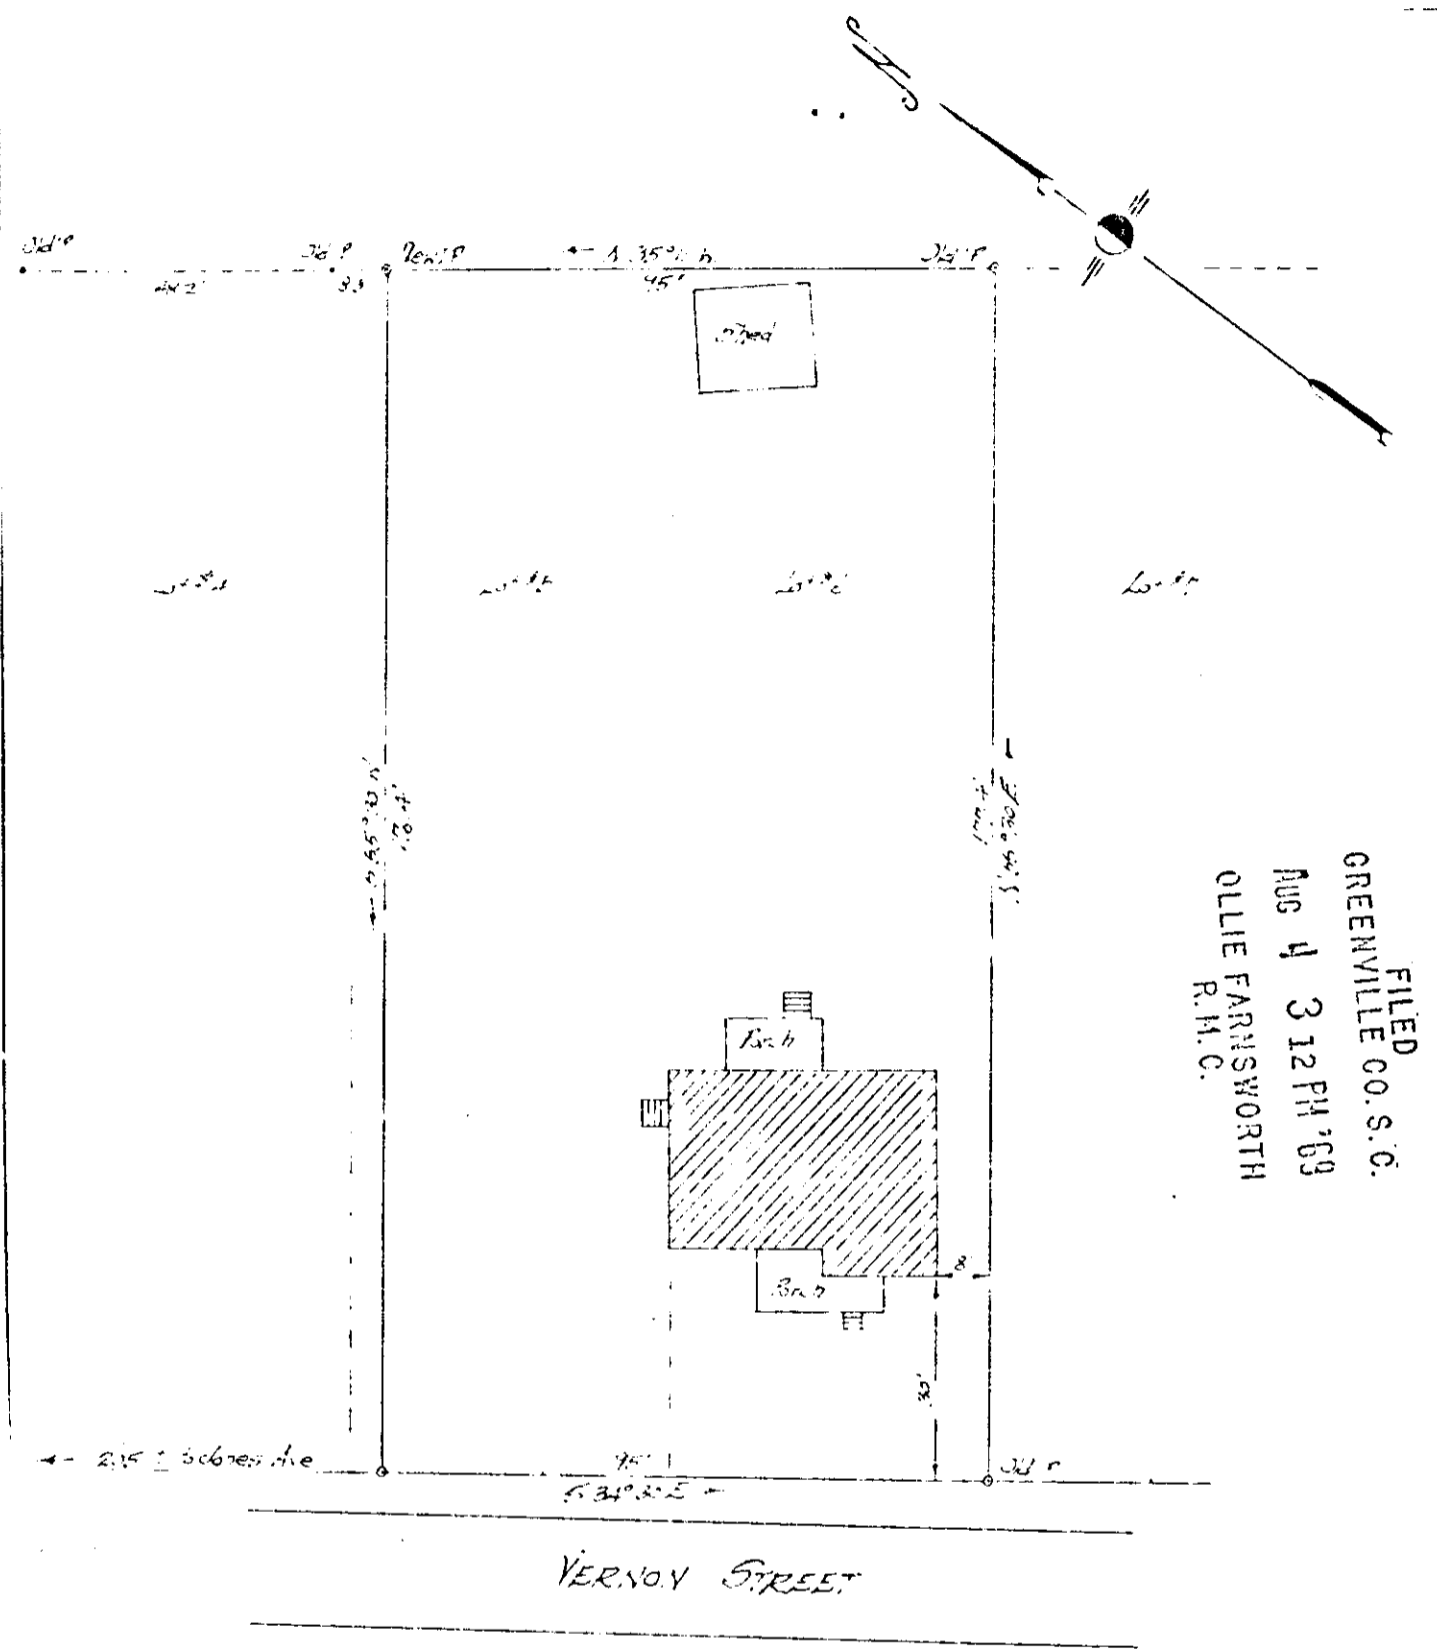

FILED  
GREENVILLE CO. S. C.  
AUG 4 3 12 PM '69  
OLLIE FARNSWORTH  
R.M.C.

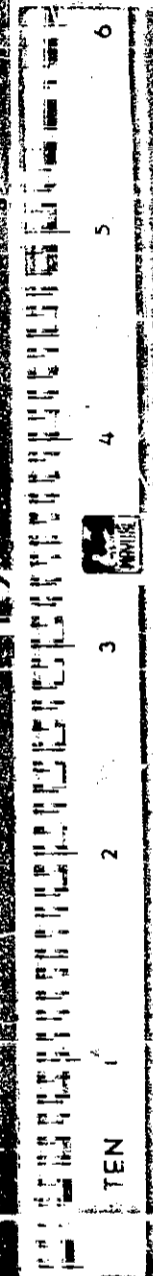

VERNOY STREET

PROPERTY OF  
JAMES C. & SHIRLEY S. GOSNELL

Located near City Limits Street

CHICK SPRINGS TOWNSHIP GREENVILLE COUNTY  
SOUTH CAROLINA

SCALE 1" = 30' HET JUNE 19 1969

Survey made June 12 1969



G7-1-9E & 9F

2793

John A. Simmons, Reg. Surveyor #2212  
GREENVILLE, S.C.

4B-177

177