


# 10330 Filed This 31 day of Oct 1969  
 And Recorded in Vol. 4C Page 131 at 12:30 P.M.  
 Ollie Farnsworth  
 Register of Deeds Greenville County, S. C.

TEN  
 1  
 2  
 3  
 4  
 5  
 6

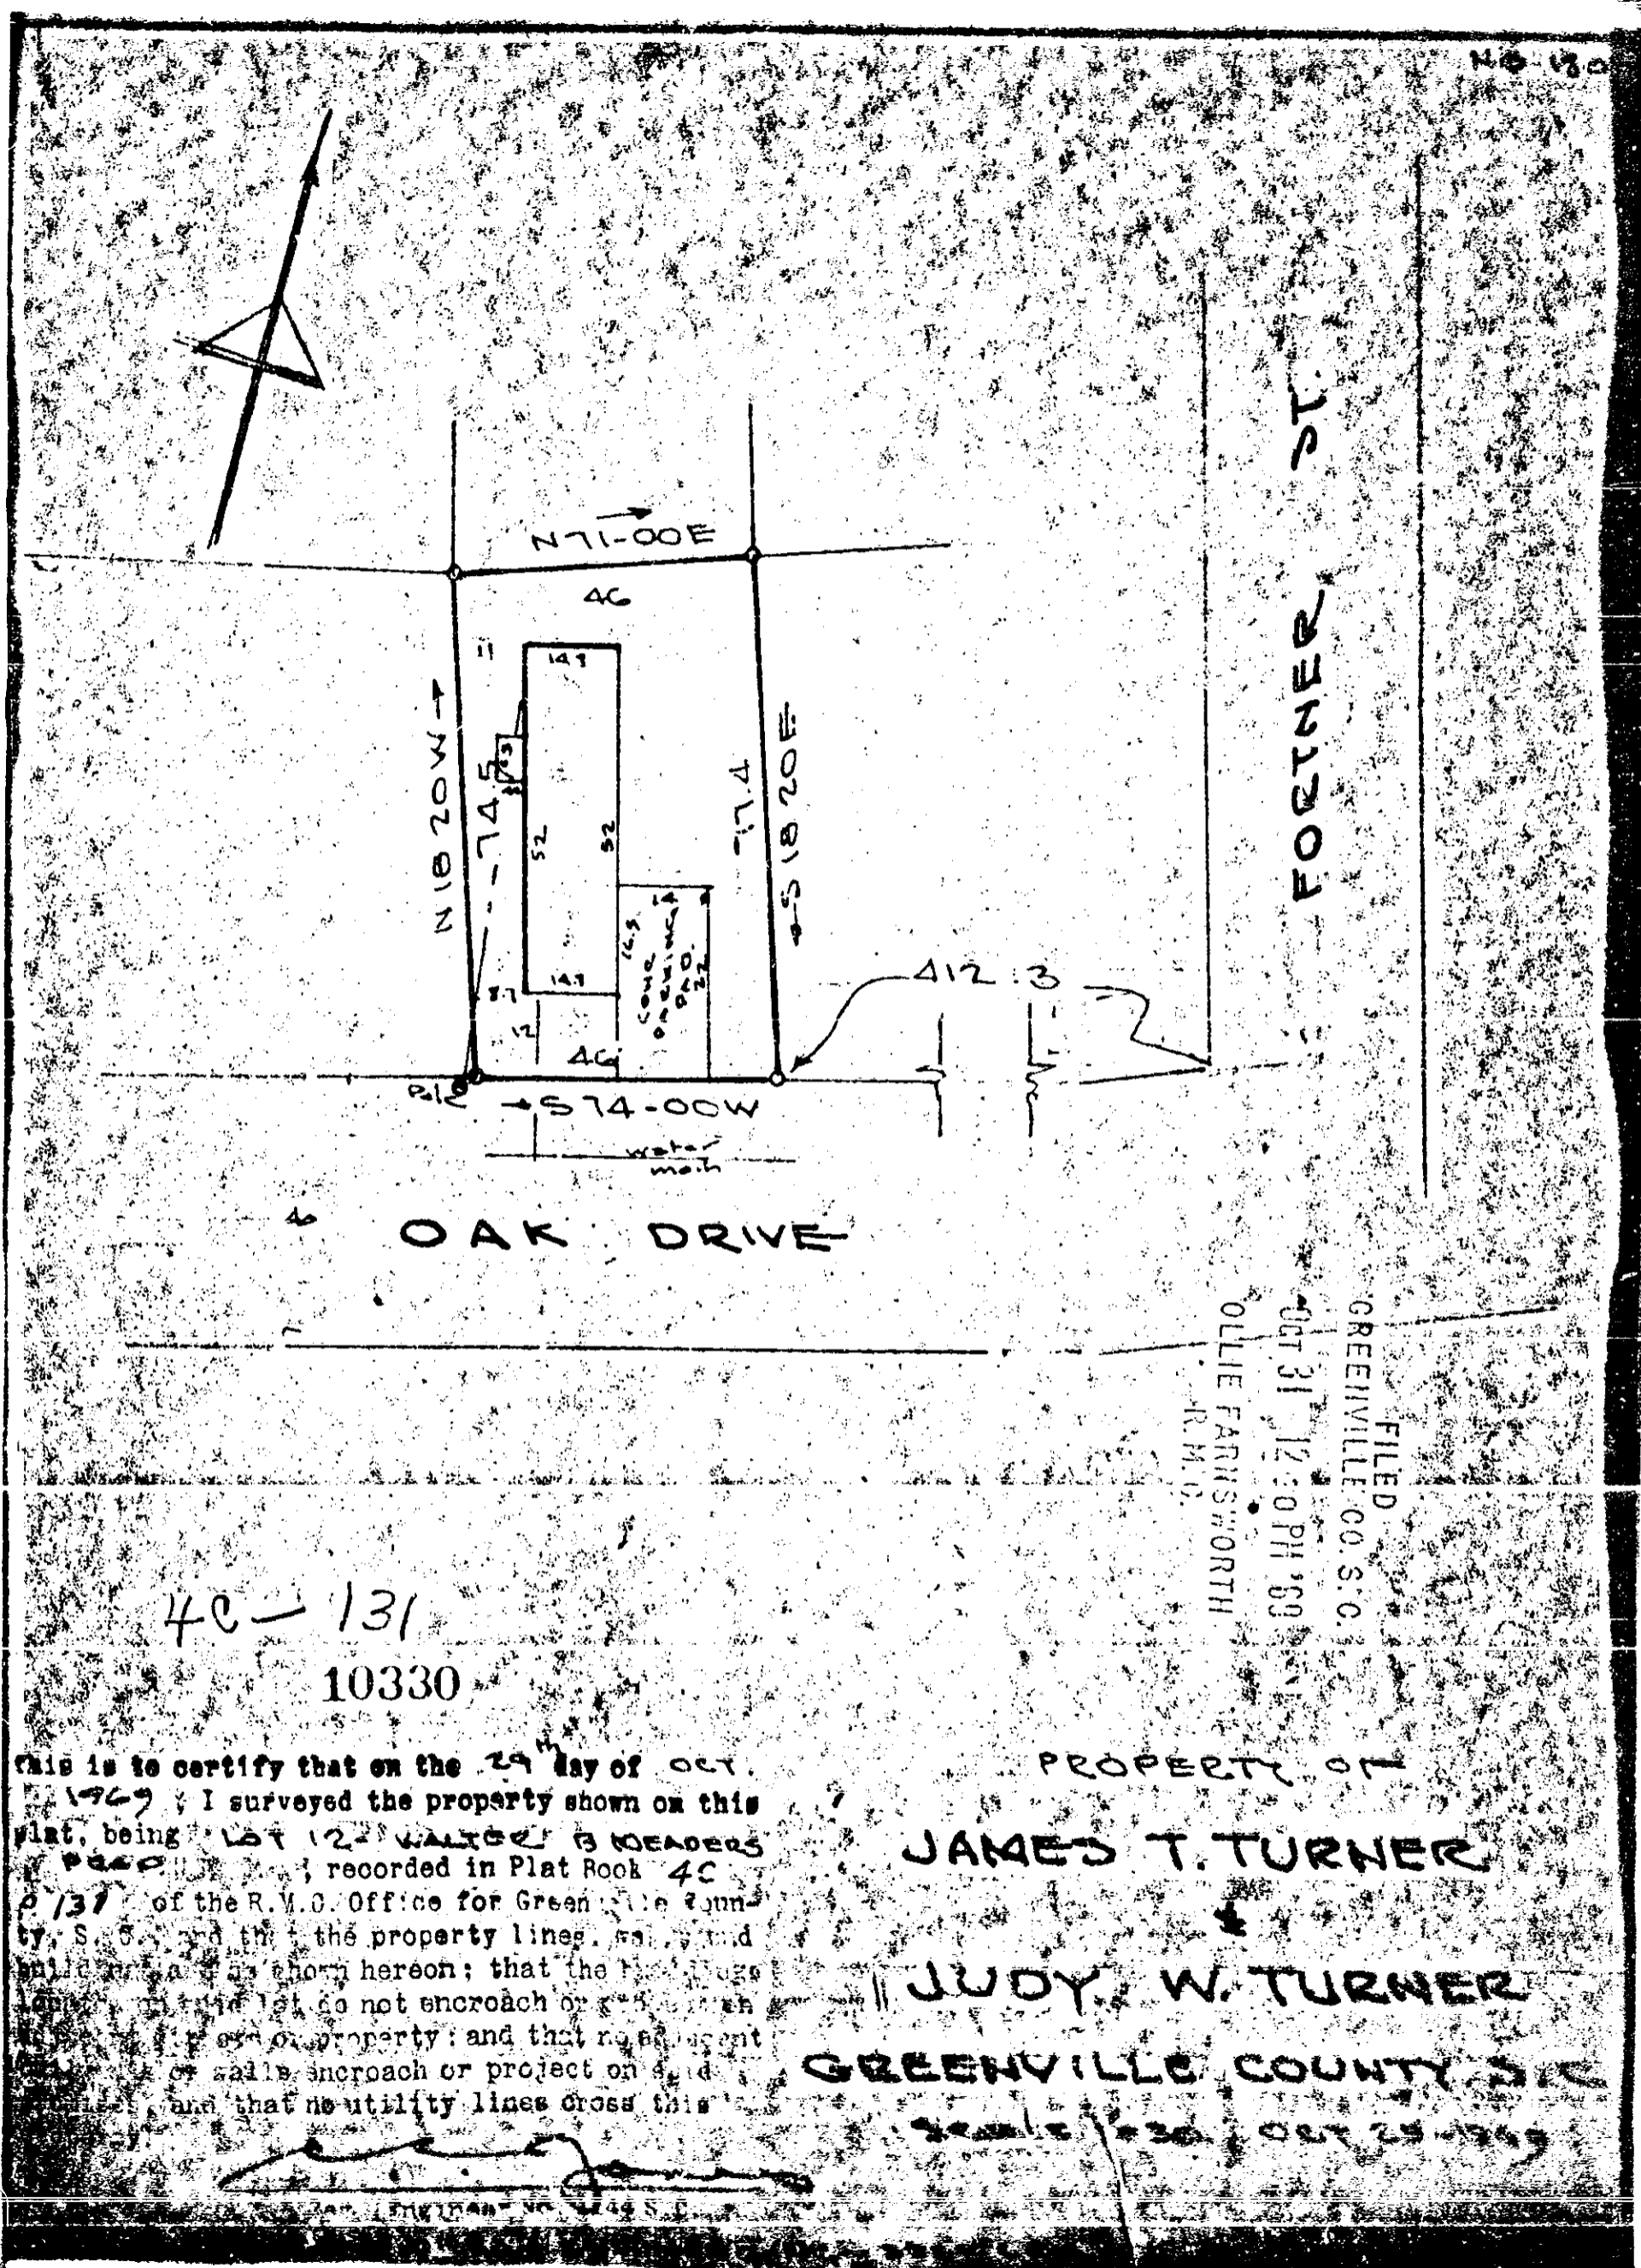

4C-131  
 10330


PROPERTY OF  
 JAMES T. TURNER  
 &  
 JUDY W. TURNER  
 GREENVILLE COUNTY, S.C.

FILED  
 GREENVILLE CO. S.C.  
 OCT 31 12 30 PM '69  
 OLLIE FARNSWORTH  
 R.M.D.

[ BAD COPY ]