


#14191 Filed This 19 day of Dec 1969
 And Recorded in Vol. 4C Page 179 at 10:37 A.M.
 Ollie Farnsworth
 Register Mesne Conveyance Greenville County, S. C.

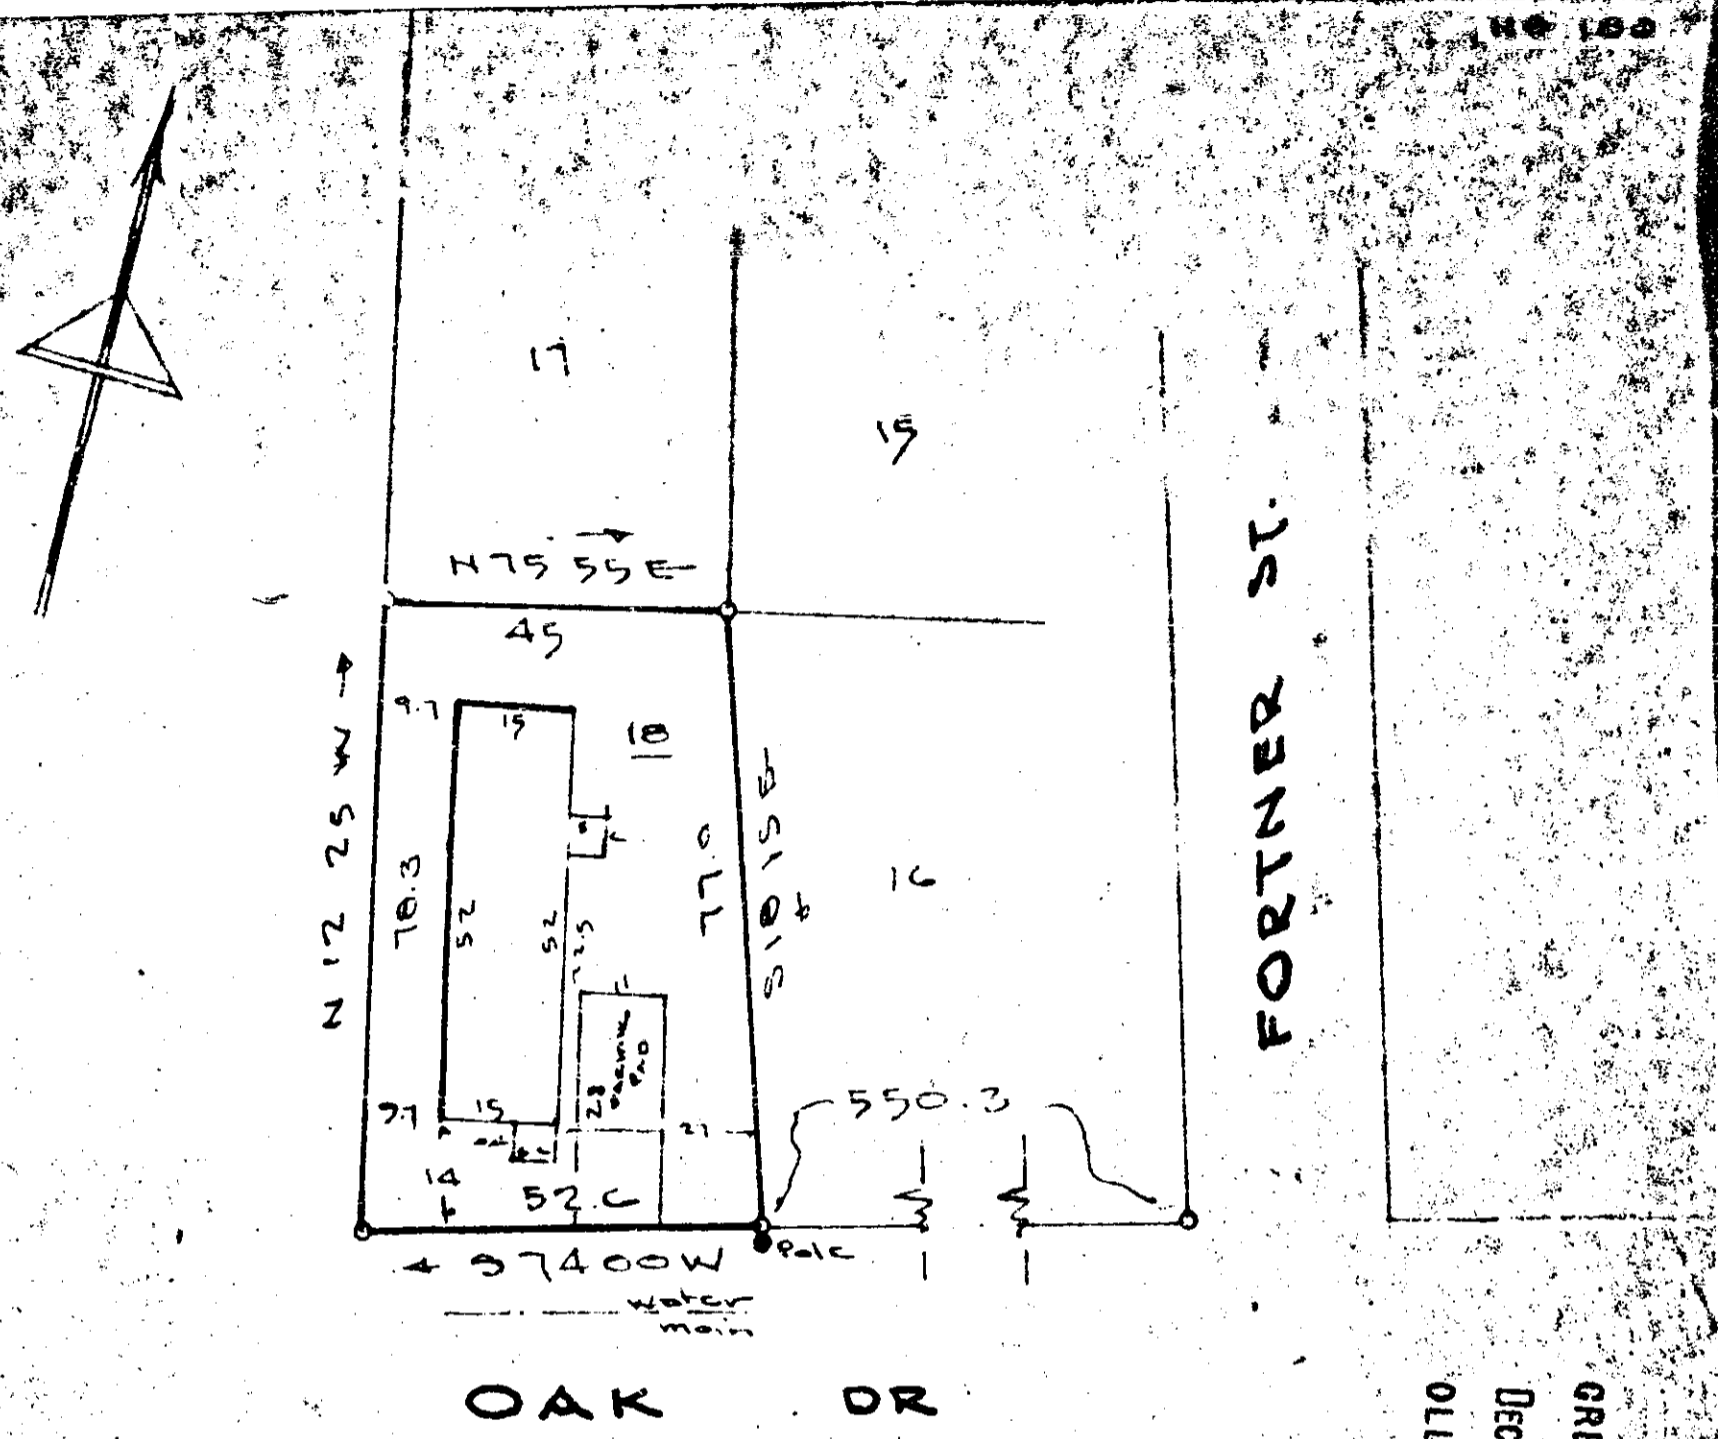

FILED
 GREENVILLE CO. S.C.
 DEC 19 10 37 AM '69
 OLLIE FARNSWORTH
 R.M.C.

14191
 DEC 19 1969
 PROPERTY OF

WILLIAM G. WATERS
 AND
 FAYE L. WATERS
 GREENVILLE COUNTY S.C.

This is to certify that on the 25th day of Nov 1969, I surveyed the property shown on this plat, being Lot 18 - Prop William G. Waters & Faye L. Waters, recorded in Plat Book 4C p. 179 of the R.M.C. Office for Greenville County, S. C., and that the property lines, walls and buildings are as shown hereon; that the buildings located on said lot do not encroach or project on adjacent streets or property; and that no adjacent buildings or walls encroach or project on said premises; and that no utility lines cross this property.

Reg. Engineer No. 11443.C.