


# 14189 Filed This 19 day of Dec 1969  
And Recorded in Vol 4 D Page 23 at 10:44 A.M.  
Ollie Farnsworth  
Register Mesne Conveyance Greenville County, S. C.

NOTE: BROKEN LINES REPRESENT OLD PROP. LINES  
SOLID LINES REPRESENT NEW PROP. LINES

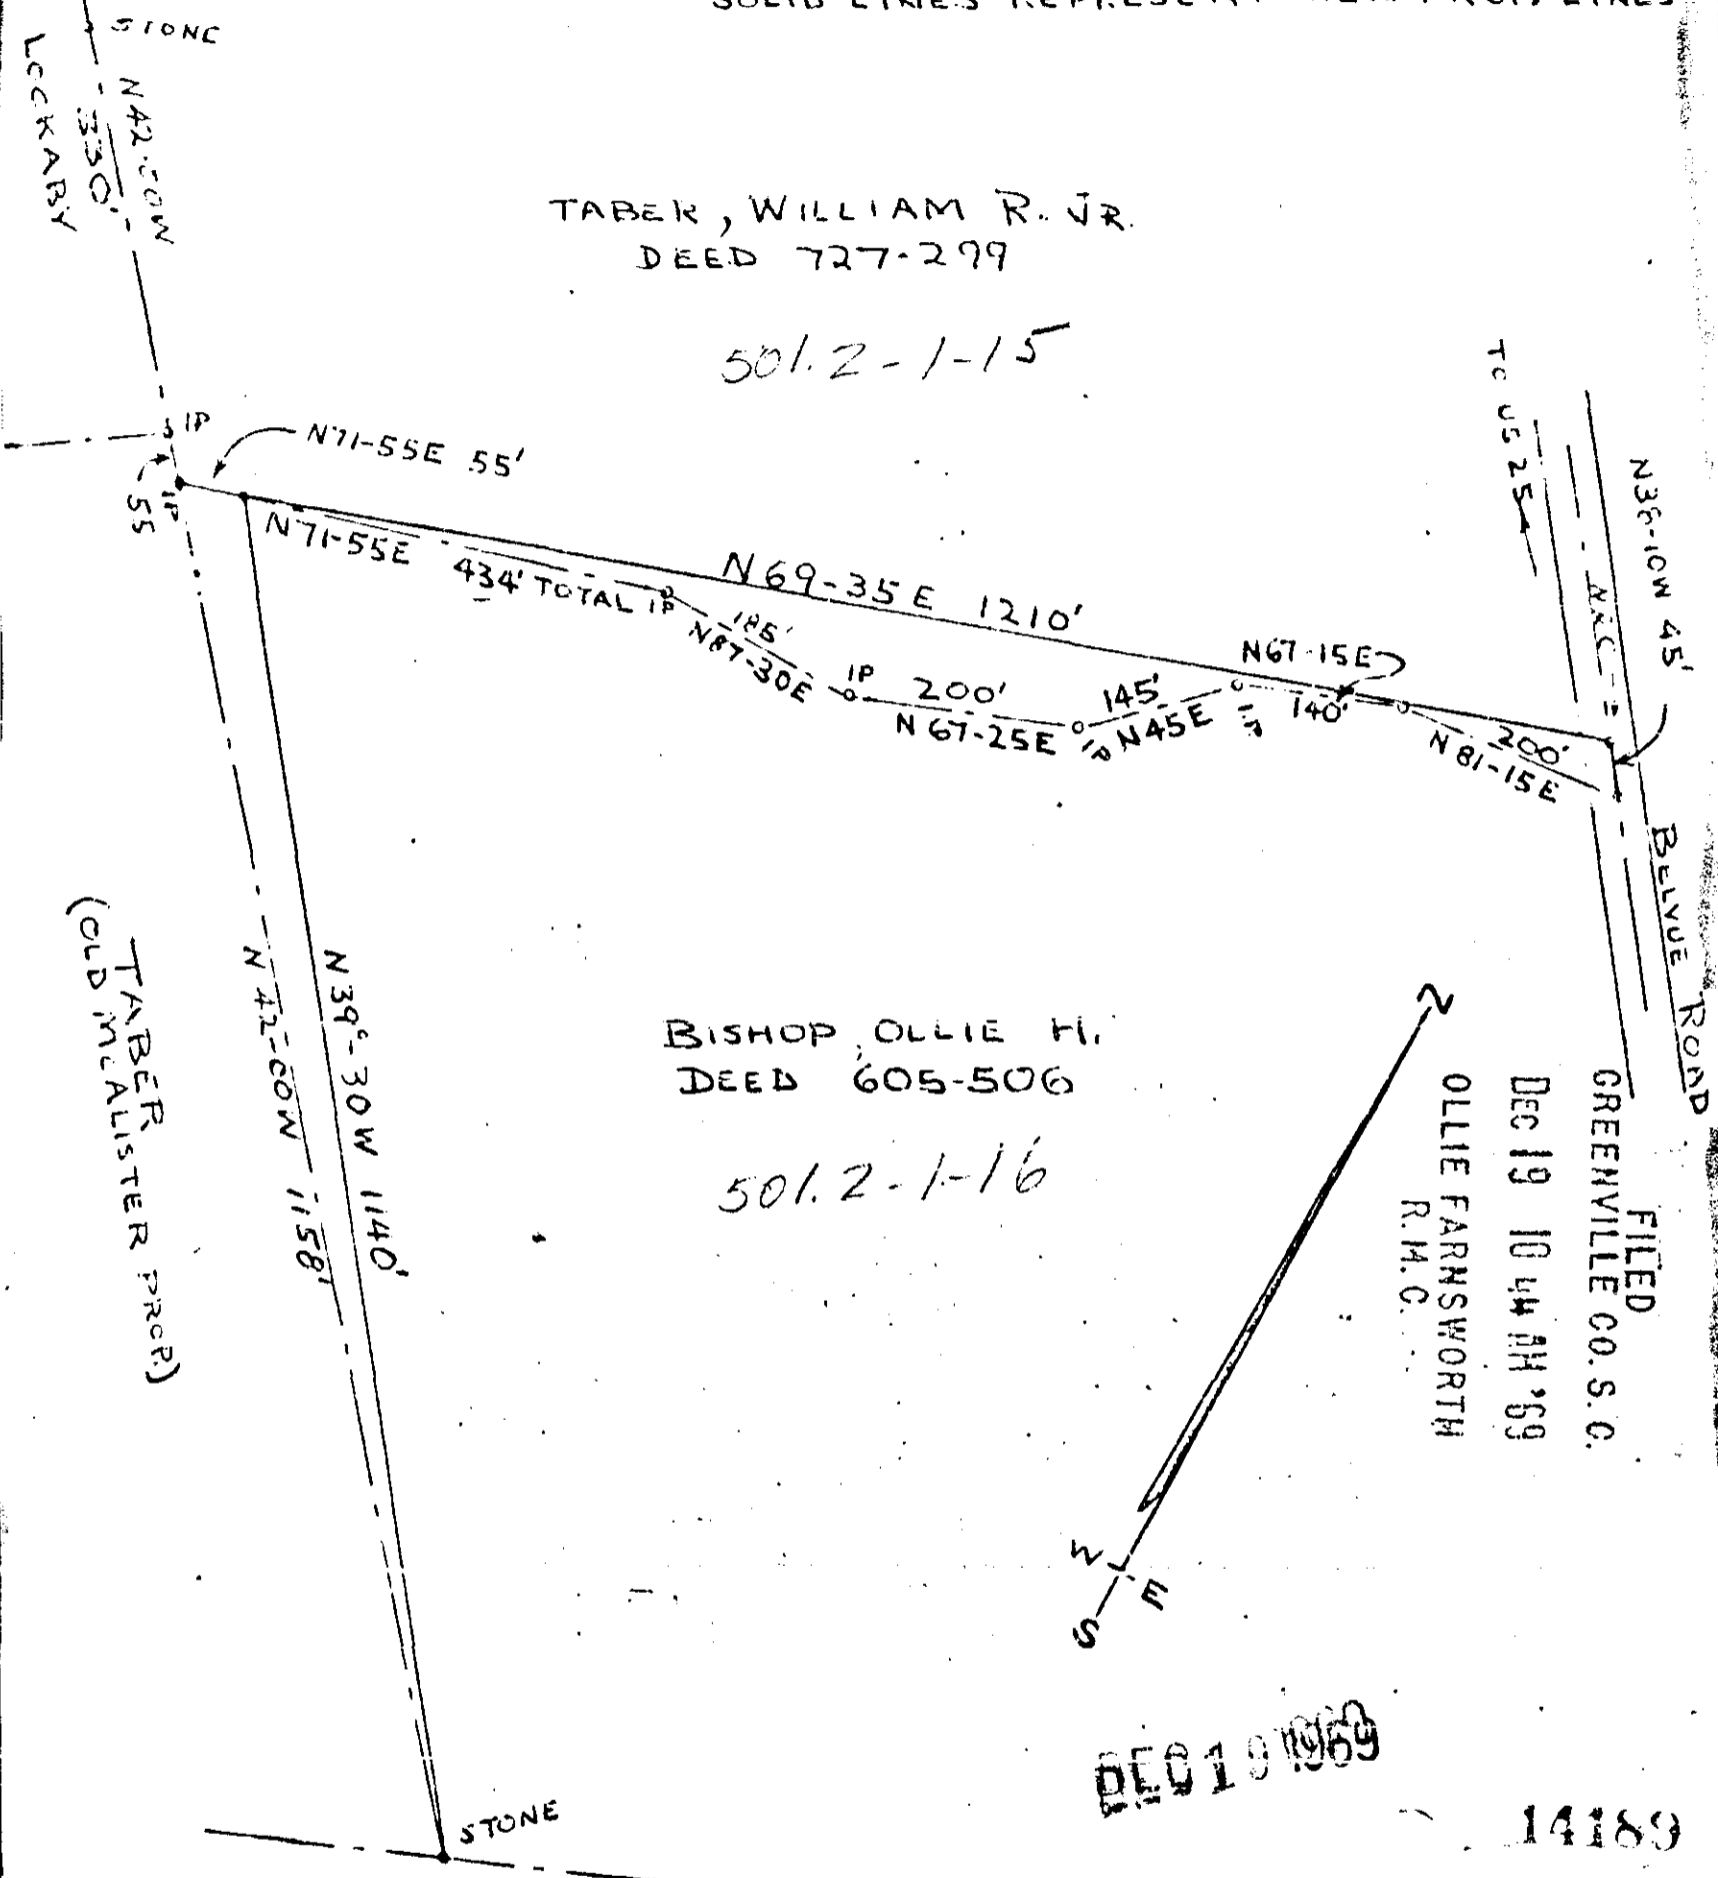

TABER, WILLIAM R. JR.  
DEED 727-299

501.2-1-15

BISHOP, OLLIE H.  
DEED 605-506

501.2-1-16

FILED  
GREENVILLE CO. S. C.  
DEC 19 10 44 AM '69  
OLLIE FARNSWORTH  
R.M.C.

DEC 19 1969 14189

PLAT OF PROPERTY OF  
WILLIAM R. TABER, JR.  
&  
OLLIE H. BISHOP  
BATES TWP. GREENVILLE CO.  
SOUTH CAROLINA

504

4D-23

SCALE 1" = 200'  
WRT

