


# Plat Book 4D, Page 167 A

#23313 Filed This 24 day of April 1970  
 And Recorded in Vol. 45 Page 167 at 3:42 P.

*Ollie Farnsworth*  
 Register Mesne Conveyance Greenville County, S. C.

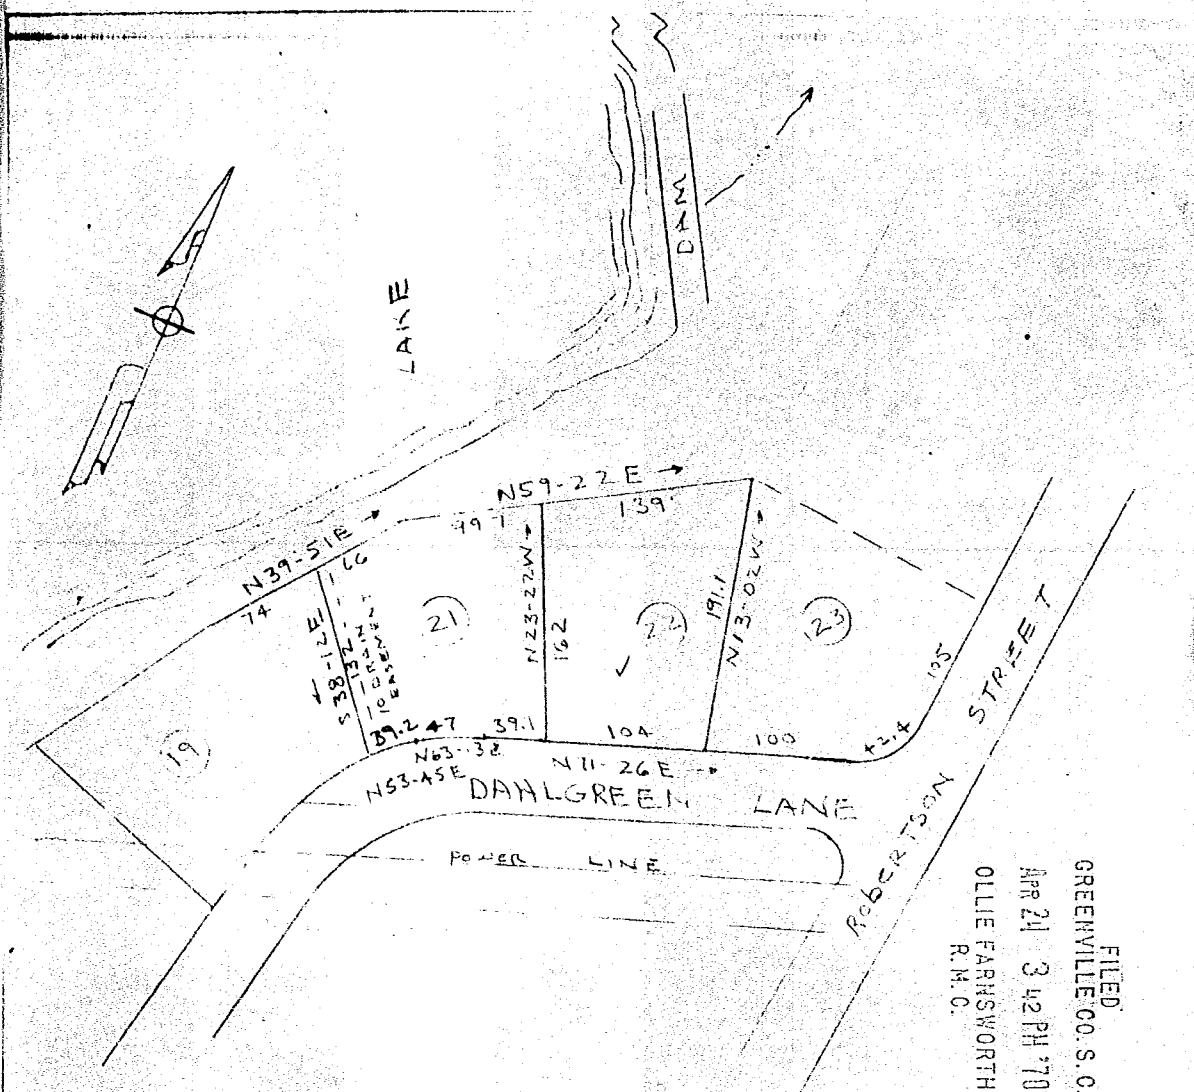

FILED  
 GREENVILLE CO. S. C.  
 APR 21 3 42 PM '70  
 OLLIE FARNSWORTH  
 R. M. C.

REVISION OF PLOTS 21 & 22

APR 24 1970  
 23313

ROLLING ACKES

NEAR THE CITY OF GREENVILLE

SEE UUU/89

GREENVILLE COUNTY S. C.

WEBB SURVEYING & MAPPING CO.

SCALE 1" = 100'

MARCH, 1970

4D-167

