


#164 Filed This 2 day of July 1971
 And Recorded in Vol. 4E Page 1 11:29 AM
 Ollie Farnsworth
 Register of Deeds Greenville County, S. C.

FILED
 GREENVILLE CO. S. C.

JUL 2 11 29 AM '71

OLLIE FARNSWORTH
 R. M. C.

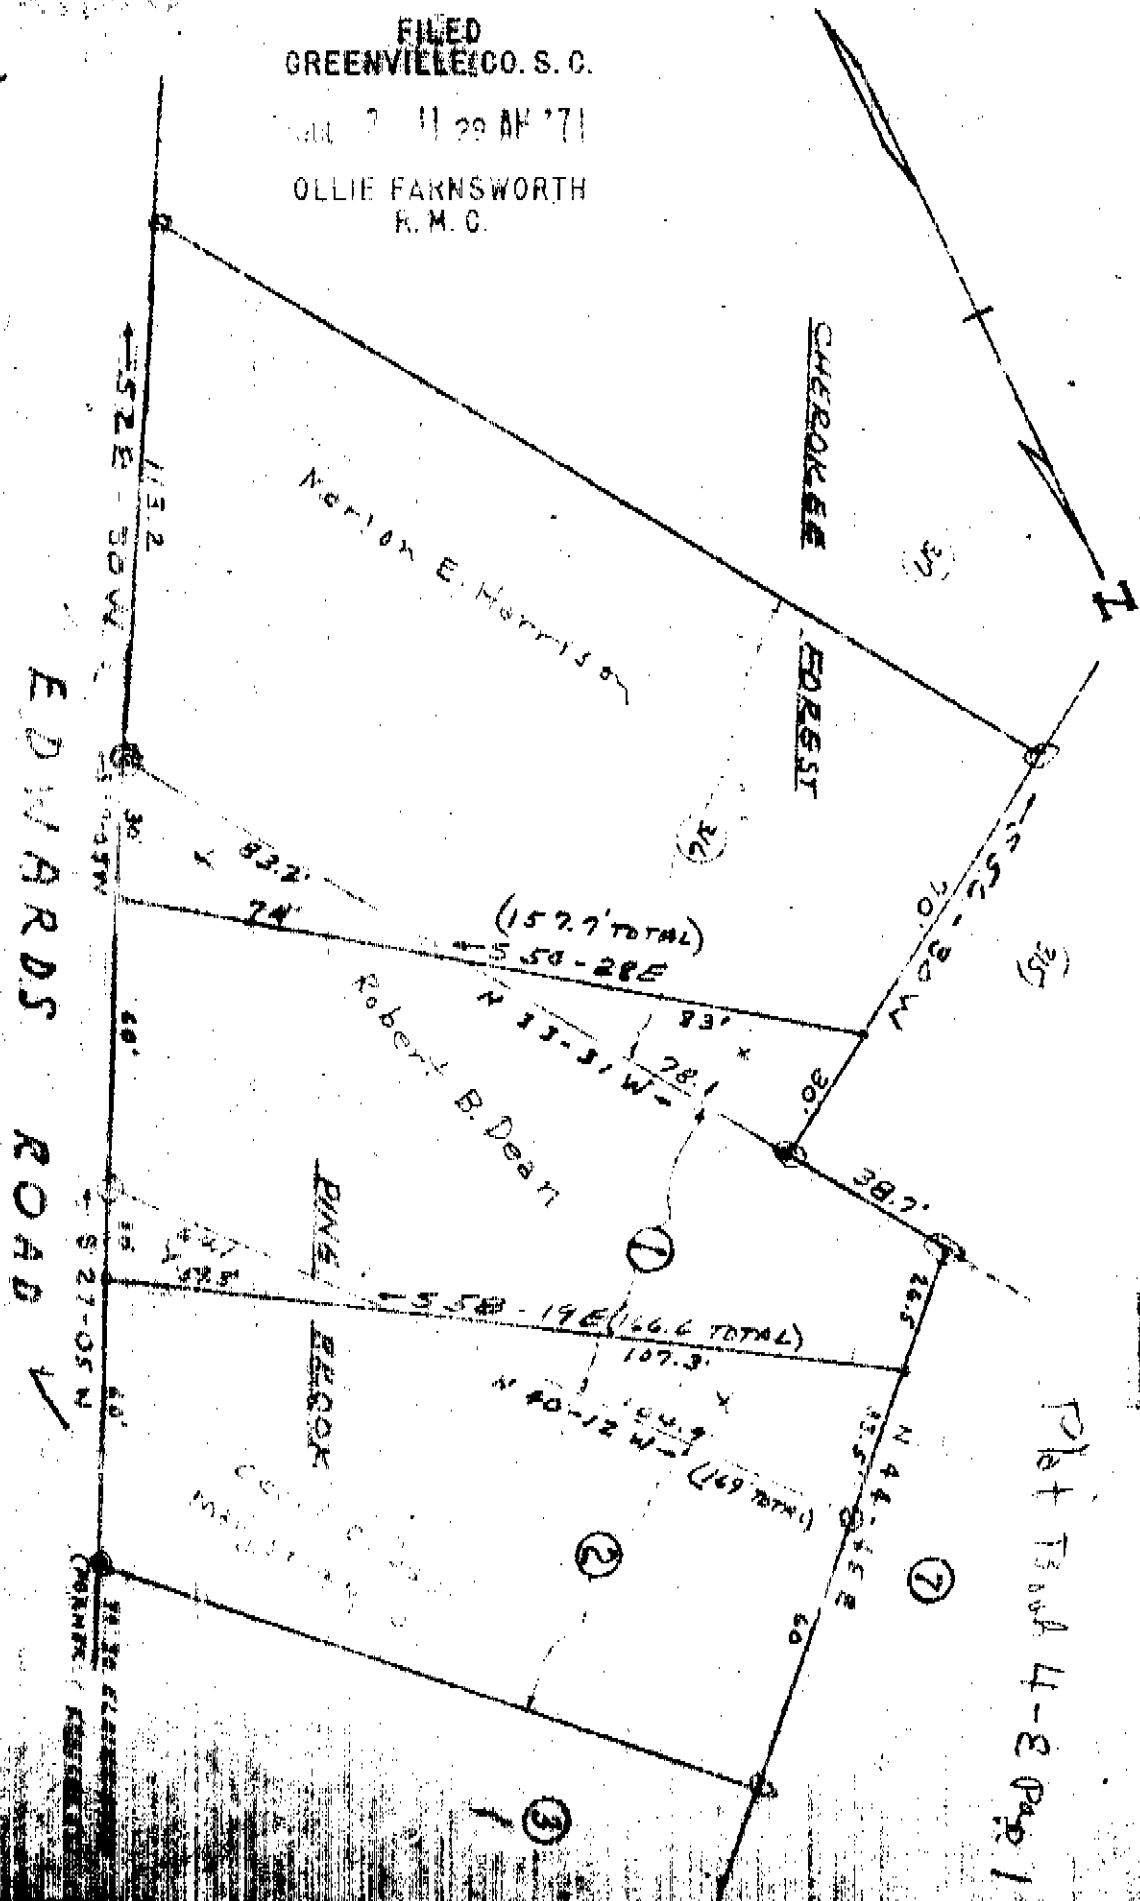

101

REVISION

LOTS 1 & 2 OF PINE BROOK
 LET NO BIG SHEROKEE FOREST
 NEAR GREENVILLE, S.C.
 APRIL 14, 1967 SCALE 1/2" = 100'

EDWARDS ROAD

Marion E. Harrison

Robert B. Dean

PINE BROOK

SHEROKEE

FOREST

Plat T3 sub 4-2 Page 1

SURVEY BY
 CAMPBELL & GARRARD
 N.C. LAND SURVEYORS
 SECELS 1125 BR