


7754 Filed This 30 day of Sept. 1970

And Received at 4:45 P.M. 1:41 A.M.

Ollie Farnsworth

Register Meane Conveyance Greenville County, S. C.

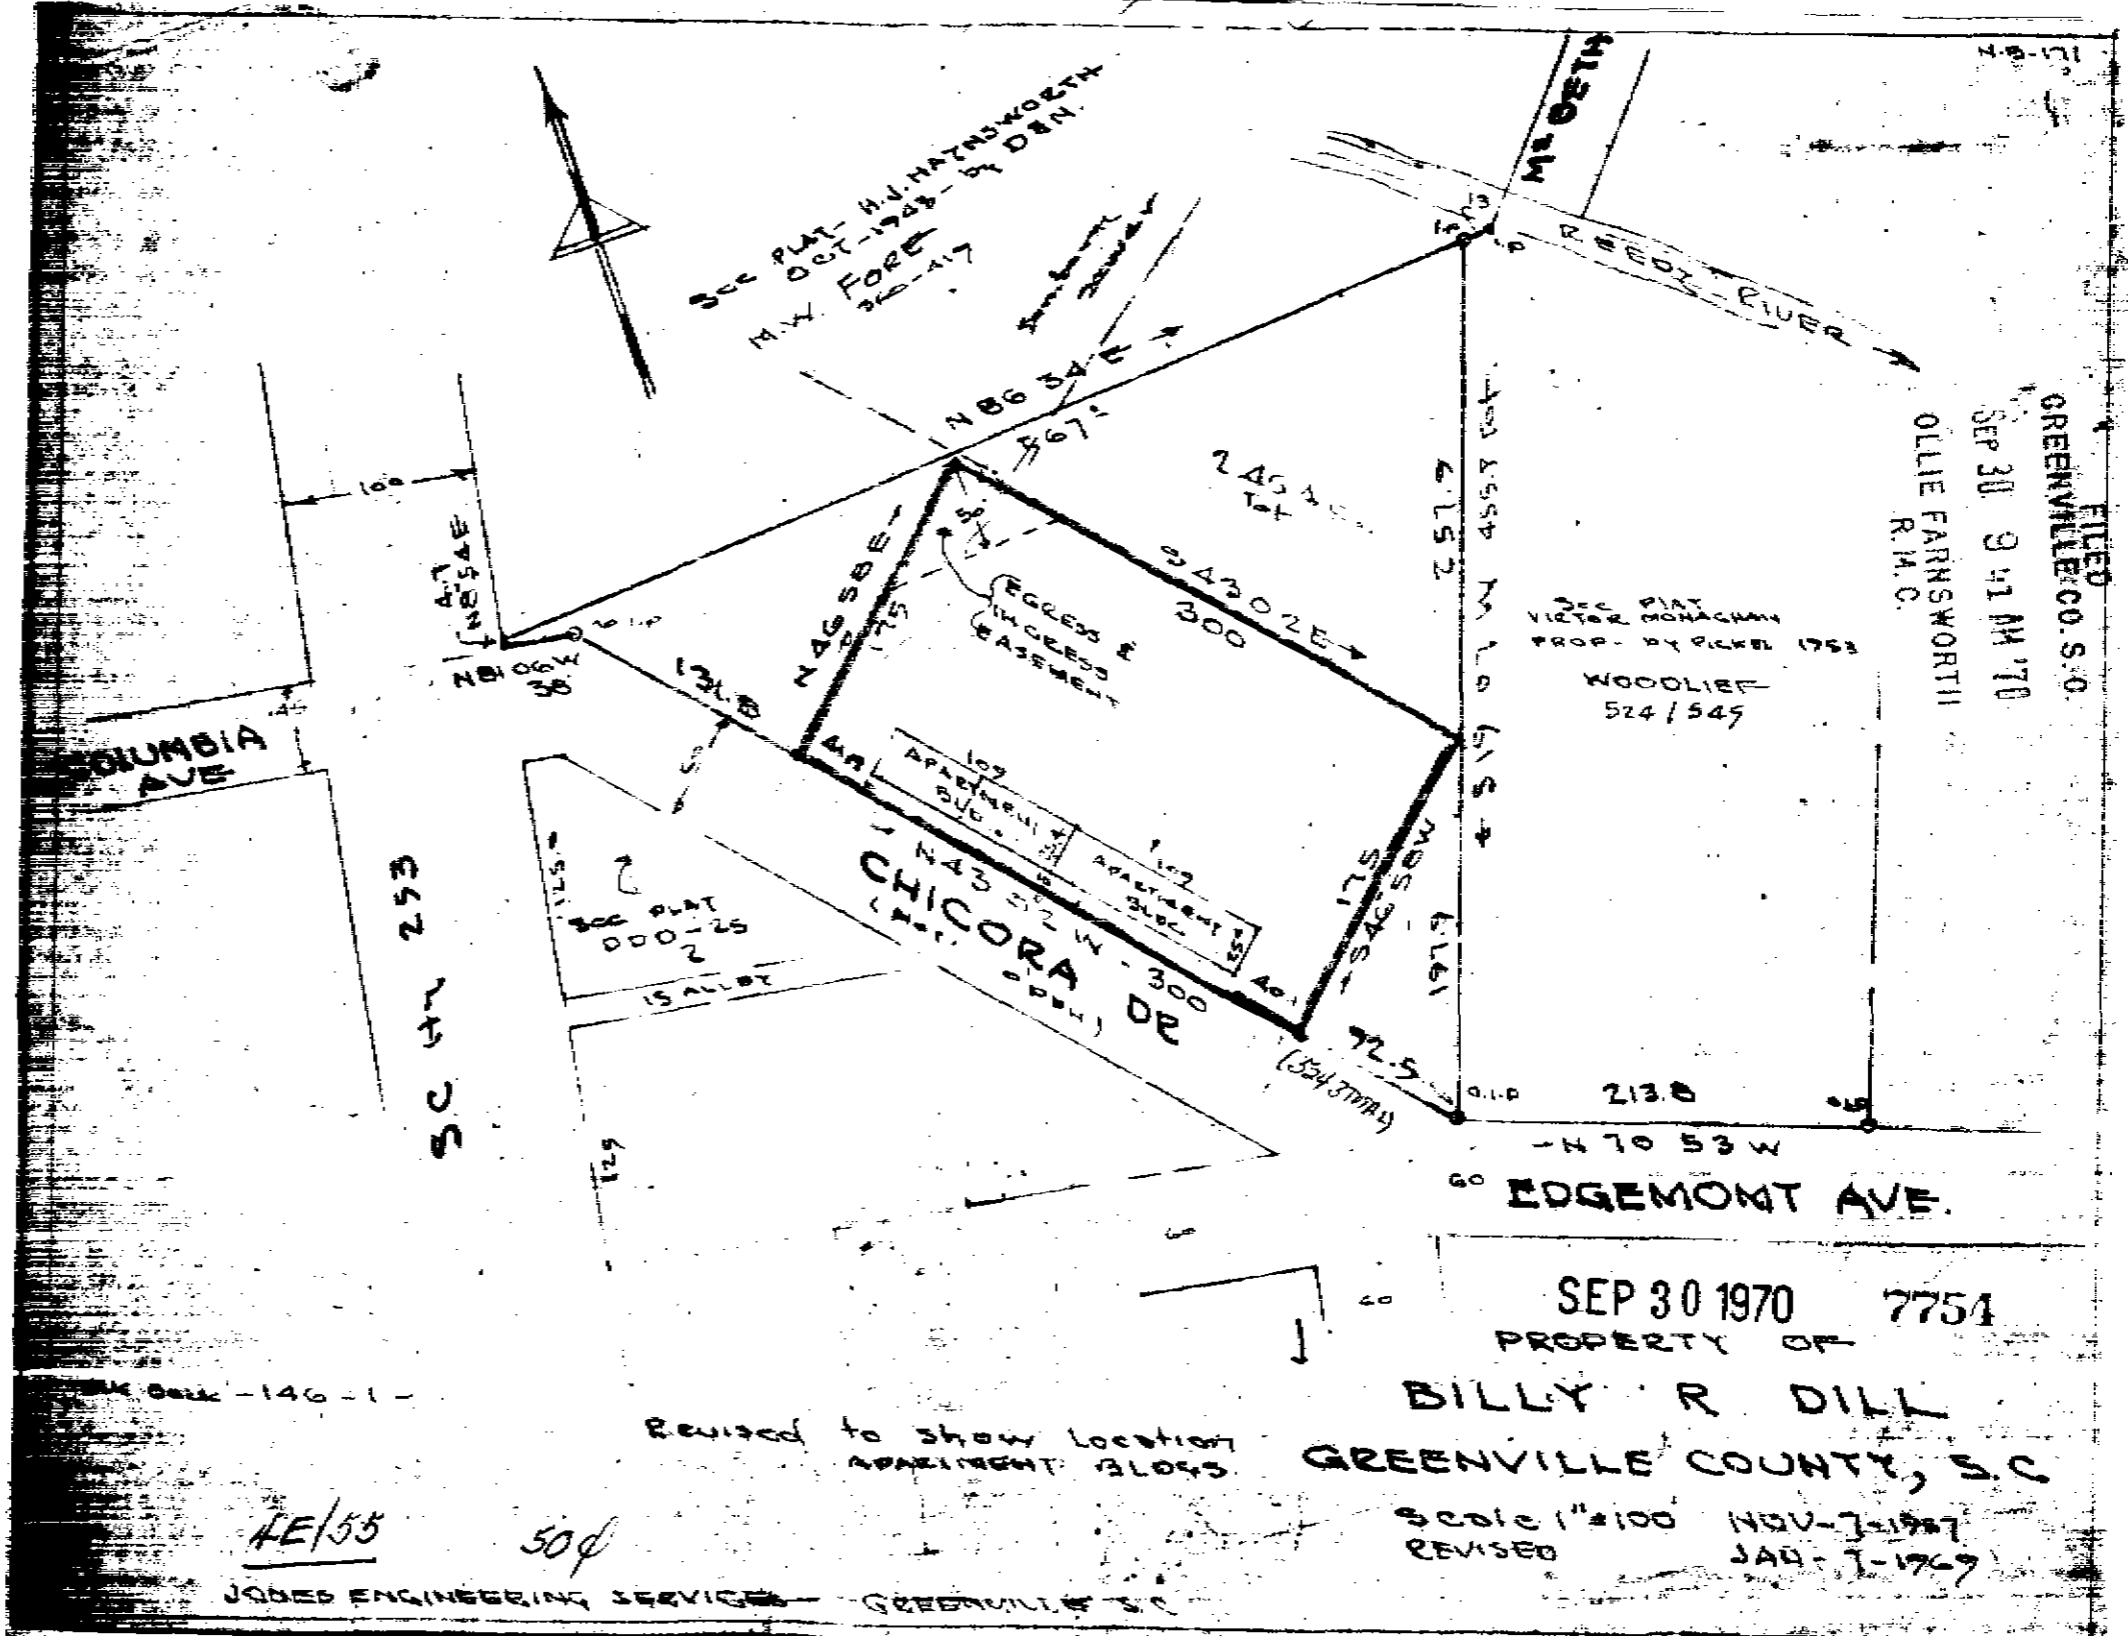

FILED
GREENVILLE CO. S.C.
SEP 30 9 41 AM '70
OLLIE FARNSWORTH
R.M.C.

SEP 30 1970 7754
PROPERTY OF
BILLY R DILL
GREENVILLE COUNTY, S.C.

Scale 1"=100
REVISED NOV-3-1967
JAN-1-1969

Revised to show location
APARTMENT BLDG.

FE/55 50¢
JONES ENGINEERING SERVICE - GREENVILLE S.C.