


#16491 Filed This 22 day of Jan. 1970  
 And Recorded in Vol. 46 at 2:55 P.M.  
 Ollie Farnsworth  
 Register of Deeds, Greenville, S. C.

# Plat Book 46, Page 25A

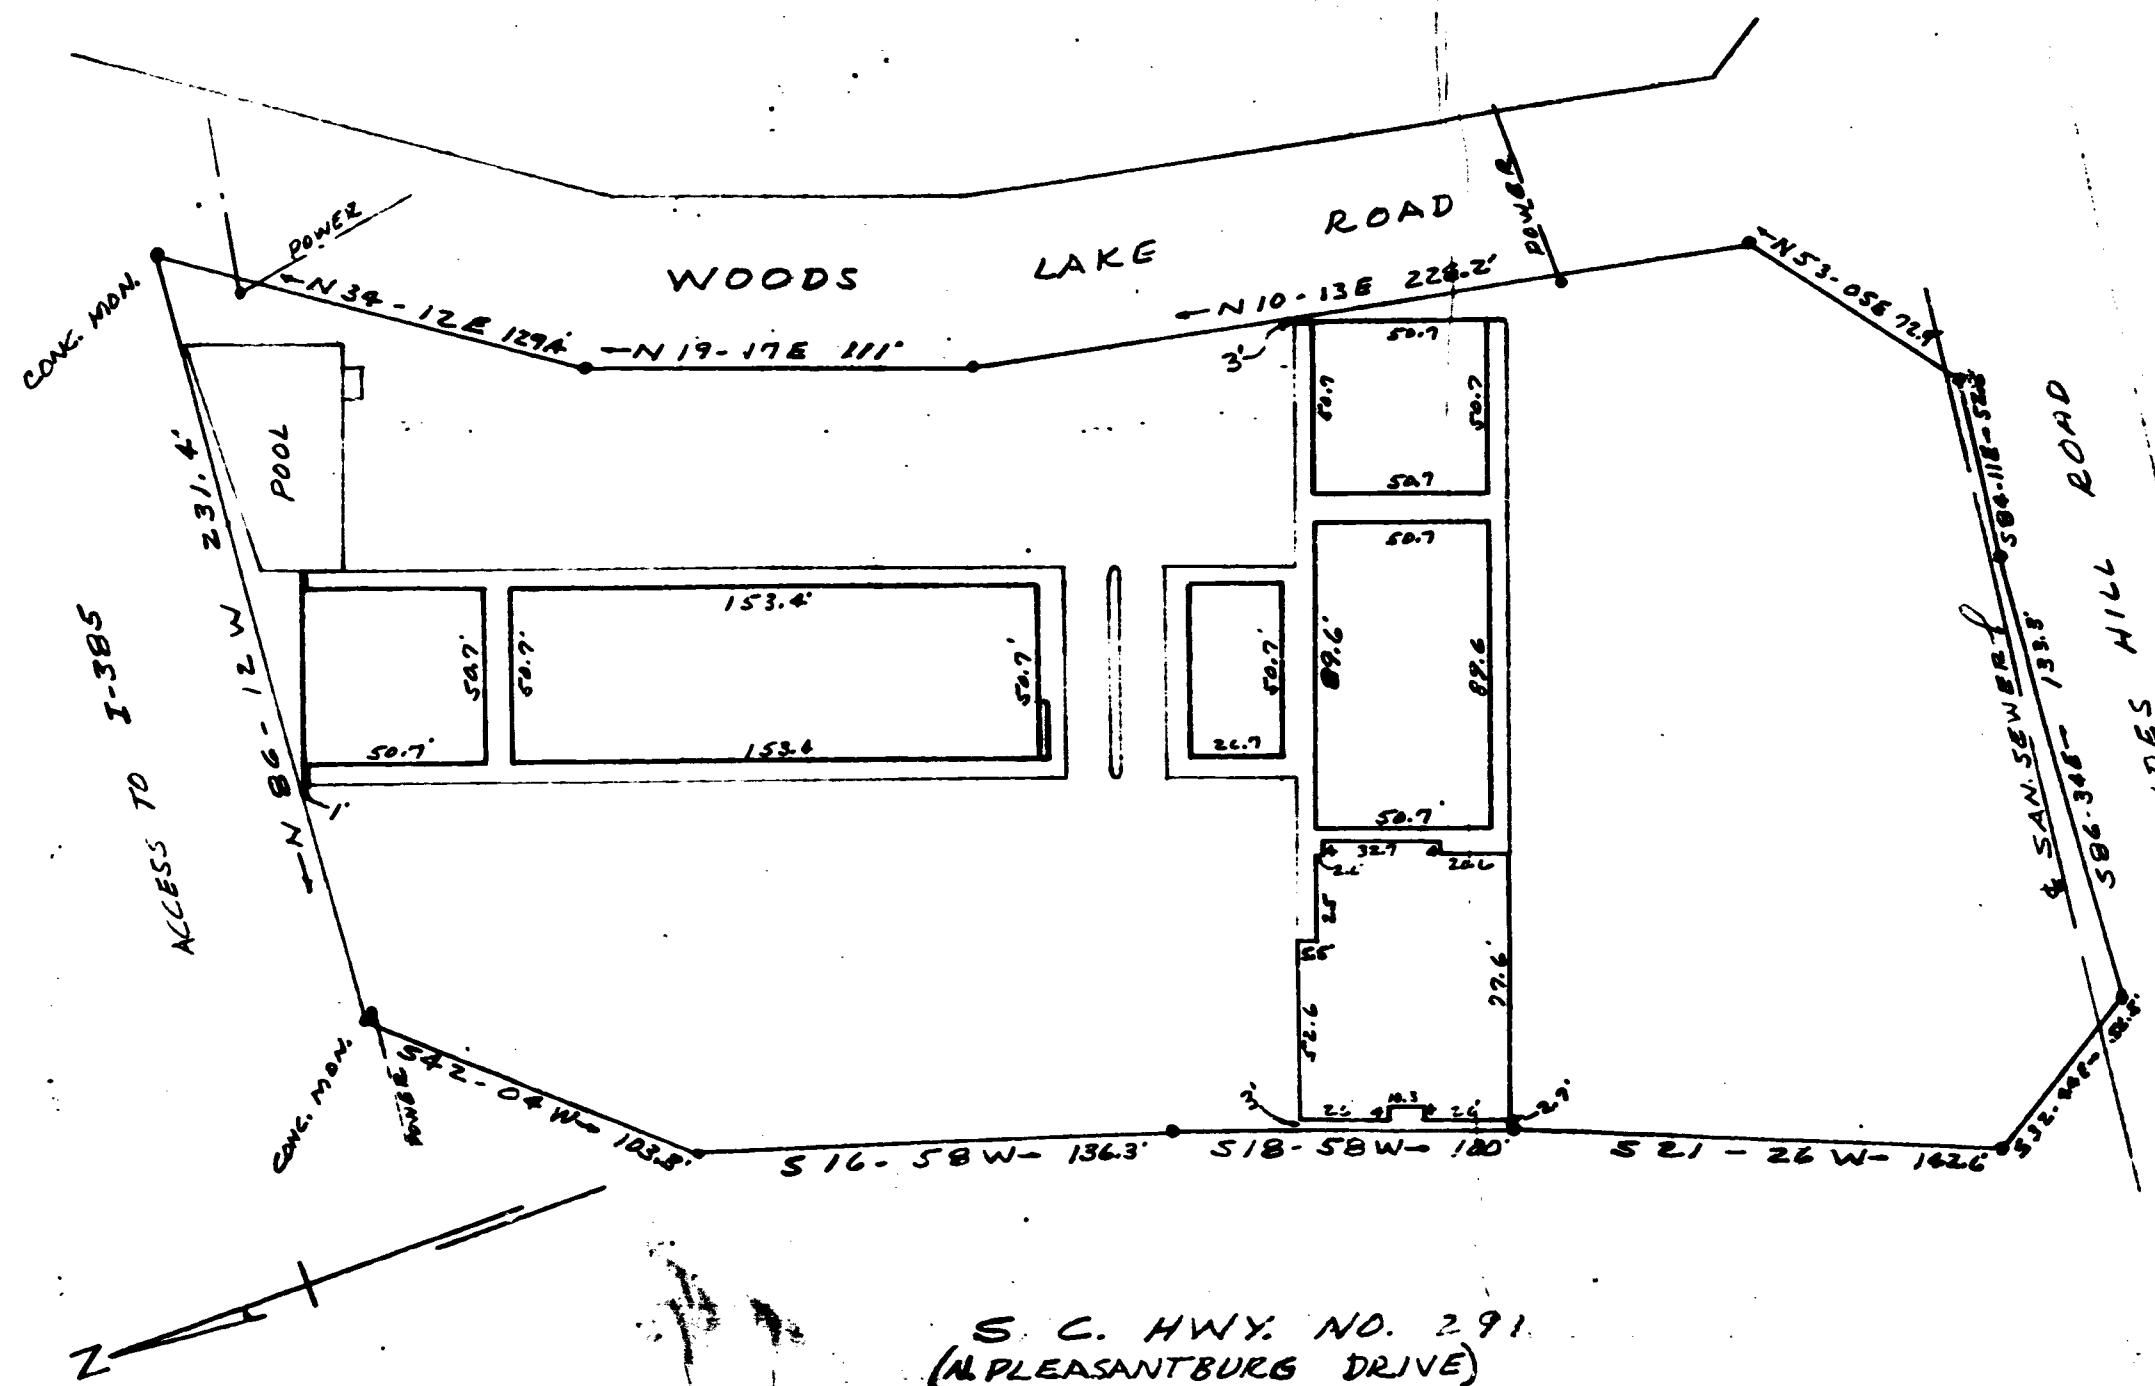

PROPERTY OF  
**GOLDEN EAGLE OF GREENVILLE, INC.**  
 GREENVILLE, S. C.  
 JAN. 13, 1970 SCALE 1"=50'  
 282-1-6

This is to certify that on Dec. 17, 1970 I surveyed the property shown on this plat, known as the Property of Golden Eagle of Greenville, Inc., as shown as plat recorded in the D.C. Office for Greenville Co., in Plat Book 46, at page 25, and that the property lines, all easements, and all other interests shown hereon, and that the building located on said property does not encroach on adjacent streets or property, and that no adjacent walls or buildings reflect on or encroach on said property, and that no utility lines cross this property except as shown hereon unless for service thereto.

H.C. Clark  
 Surveyors, Inc.

JAN 22 1970  
 OLLIE FARNSWORTH  
 R.M.O.  
 JAN 22 2 55 PM '70  
 GREENVILLE CO. S. C.

For revision of this plat see plat book 49 at page 27 dated Jan. 13, 1970.