


Plat Book 4H, Page 43 B

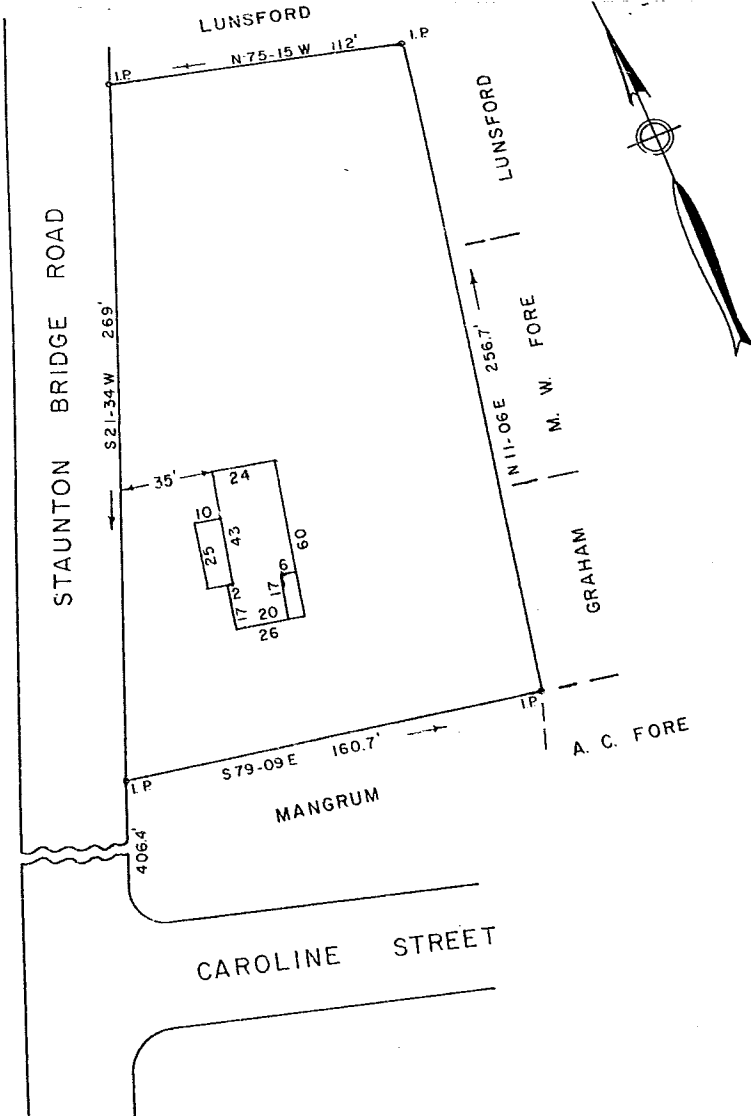

FILED
GREENVILLE CO. S. C.
OCT 12 12 31 PM '70
OLLIE FARNSWORTH
R.M.C.

PROPERTY OF
JAMES A. JACKSON
PHYLLIS T. JACKSON

GREENVILLE CO., S. C.

Scale 1" = 50' Oct., 1970

8736
And Recorded in Vol. 4H 439
12:31 P.
1970
Miss Farnsworth
Register Messrs. Engineers Greenville County, S. C.

This is to certify that on the 7th day of October, 1970, I surveyed the property shown on this plat; being shown on plat of James A. Jackson & Phyllis T. Jackson, Recorded in Plat Book 4H page 43, Office of R.M.C. Greenville Co., S.C. and that the property lines, walls and buildings are as shown hereon; that the buildings located on said property do not encroach or project on adjacent streets or property; and that no adjacent buildings or walls encroach or project on said premises.

47-43 ✓
OCT 12 1970

R. W. Dalton
Dalton & Neves Co., Engineers

8736