


19428 Filed This 22 day of Feb. 1971
 And P. 4 I 35 at 2:49 P.
 Ollie Farnsworth
 Register of Deeds Greenville County, S. C.

RECORDING FEE
 PAID \$ 50

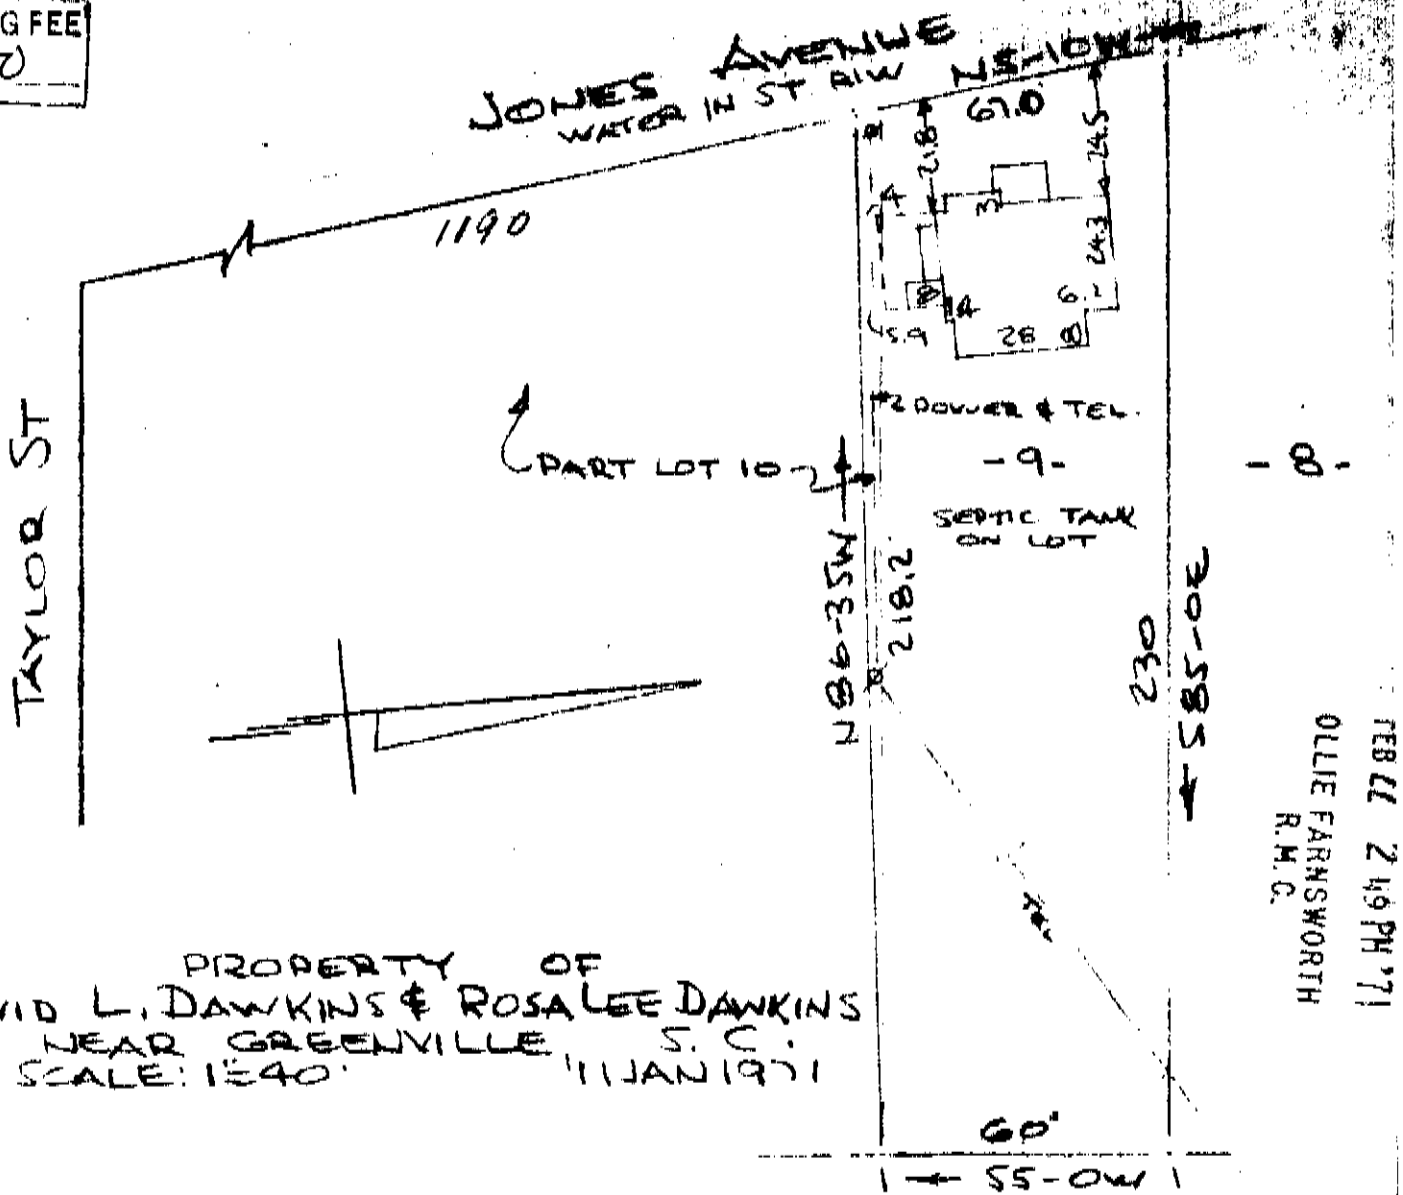

FEB 22 2 49 PM '71
 OLLIE FARNSWORTH
 R.M.C.

PROPERTY OF
 DAVID L. DAWKINS & ROSA LEE DAWKINS
 NEAR GREENVILLE S. C.
 SCALE: 1"=40' 11 JAN 1971

This is to certify that on the 11th day of January 1971, I surveyed the property shown on this plat, being known as lot 9 & part of lot 10 on plat of DAVID L. DAWKINS & ROSA LEE DAWKINS and recorded in the RMC Office Greenville County, S.C., in Plat Book 42 at Page 35; and that the property lines, walls and buildings are as shown hereon, and that the walls and buildings located on said property do not encroach or project on adjacent street or property, and that no adjacent walls or buildings encroach or project on said premises, and no power lines cross this property except as shown hereon.

F. B. Bruce
 F. B. Bruce, RLS #1952

FEB 22 1971

19428

4 I - 35

CAROLINA SURVEYING COMPANY
 Greenville, S. C.