


# 19767 Filed This 25 day of Feb. 1971  
 And Recorded in Vol. 41 Page 51 at 10:06 A.M.  
 Ollie Farnsworth,  
 Register Mesne Conveyance Greenville County, S. C.

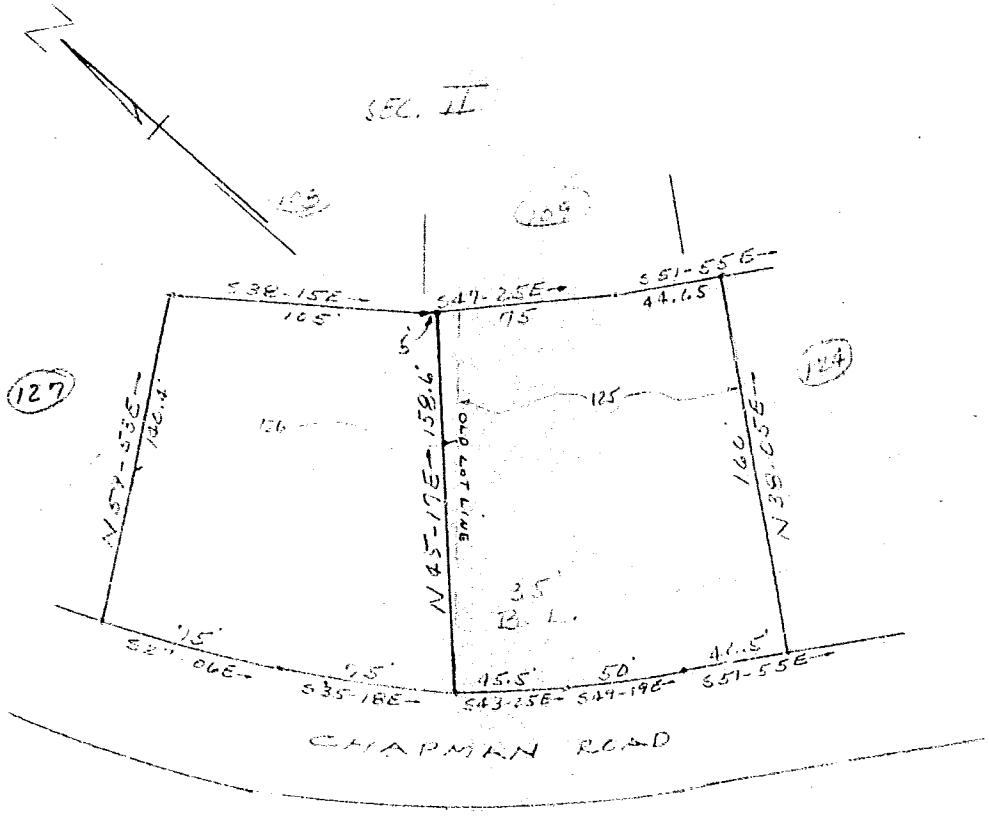

REVISION  
 LOTS 125 & 126 - SECTION III  
 CHANTICLEER  
 NEAR GREEN HILL, S.C.  
 JAN. 14, 1971 SCALE 1"=60'

FILED  
 GREENVILLE CO. S.C.  
 FEB 25 10 06 AM '71  
 OLLIE FARNSWORTH  
 R.H.C.

BY: CAMPBELL & CLARKSON  
 SURVEYORS, INC.  
 R. C. Clarkson  
 SC 221 N 4587

THIS PLAT IS NOT A SUBDIVISION  
 AS DEFINED BY THE GREENVILLE  
 COUNTY SUBDIVISION REGULATIONS.  
 2/25/1971 *Dore M. Wagner for*  
 Chairman, Secretary, or Director of  
 Planning.  
 Greenville County Planning Commission

41-51 FEB 25 1971

