


27863 Filed This 31 day of May 1971
 And Recorded in Vol. 4I Page 63 at 2:28 PM
Ollie Farnsworth
 Register Board Greenville County, S. C.

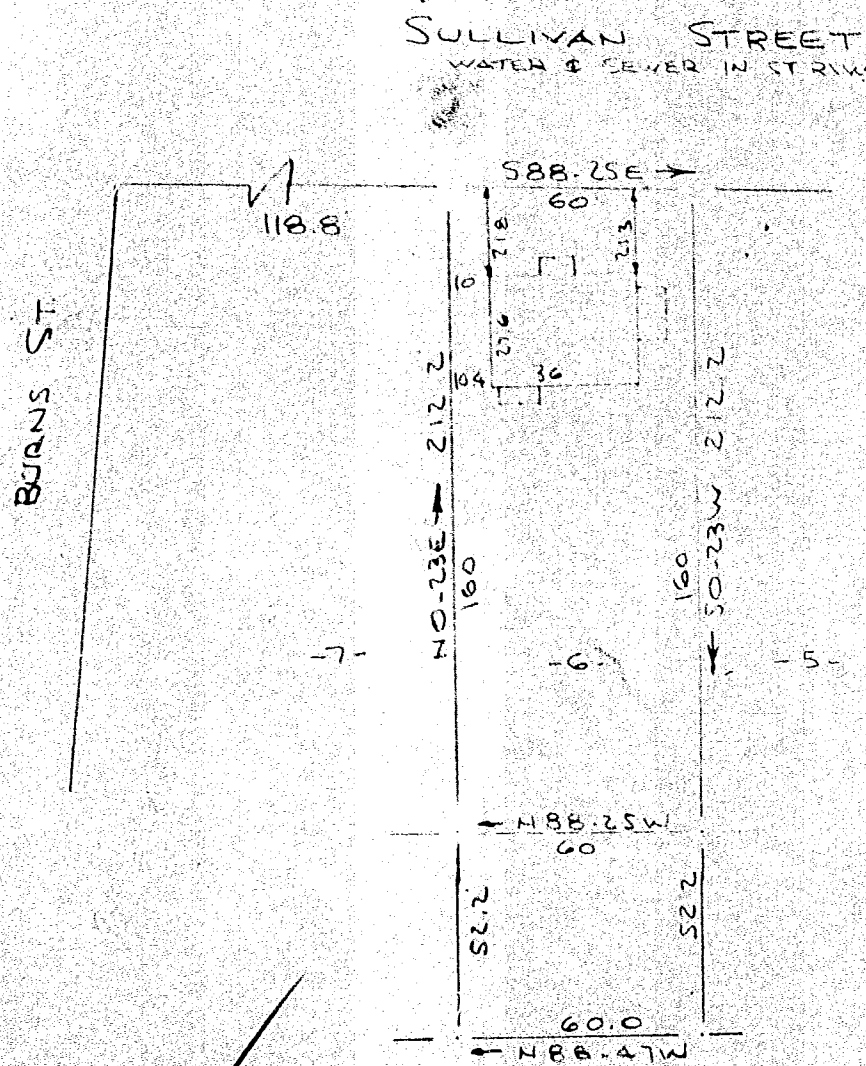

FILED
 GREENVILLE CO. S. C.
 MAY 21 2 29 PM '71
 OLLIE FARNSWORTH
 R.M.C.

PROPERTY OF JOHN T. BARRYMORE
 GREENVILLE, S. C.
 SCALE: 1" = 40'
 1 MAR 1971 27863

This is to certify that on the 1st day of March 1971, I surveyed the property shown on this plat, being known as lot 6 & portion of lot at rear on plat of PROP OF S. O. SKELTON and recorded in the RMC Office Greenville County, S.C., in Plat Book "E" at Page 282 and also being known as PROPERTY OF JOHN T. BARRYMORE and recorded in Plat Book 4I at Page 63; and that the property, lines, walls and buildings are as shown hereon, and that the walls and buildings located on said property do not encroach or project on adjacent street or property, and that no adjacent walls or buildings encroach or project on said premises, and no power lines cross this property except as shown hereon.

R. B. Bruce
 R. B. Bruce, RLS #1952

RECORDING FEE PAID \$ 50/-

CAROLINA SURVEYING COMPANY

