


23987 Filed This 14 day of Apr 1971
 And Recorded in Vol. 4 I Page 73 at 11:53 A.M.
 Ollie Farquhar
 Register Meets Conveyance Greenville County, S. C.

FILED
 GREENVILLE CO. S. C.
 APR 14 11 53 AM '71
 OLLIE FARQUHAR
 R. M. C.

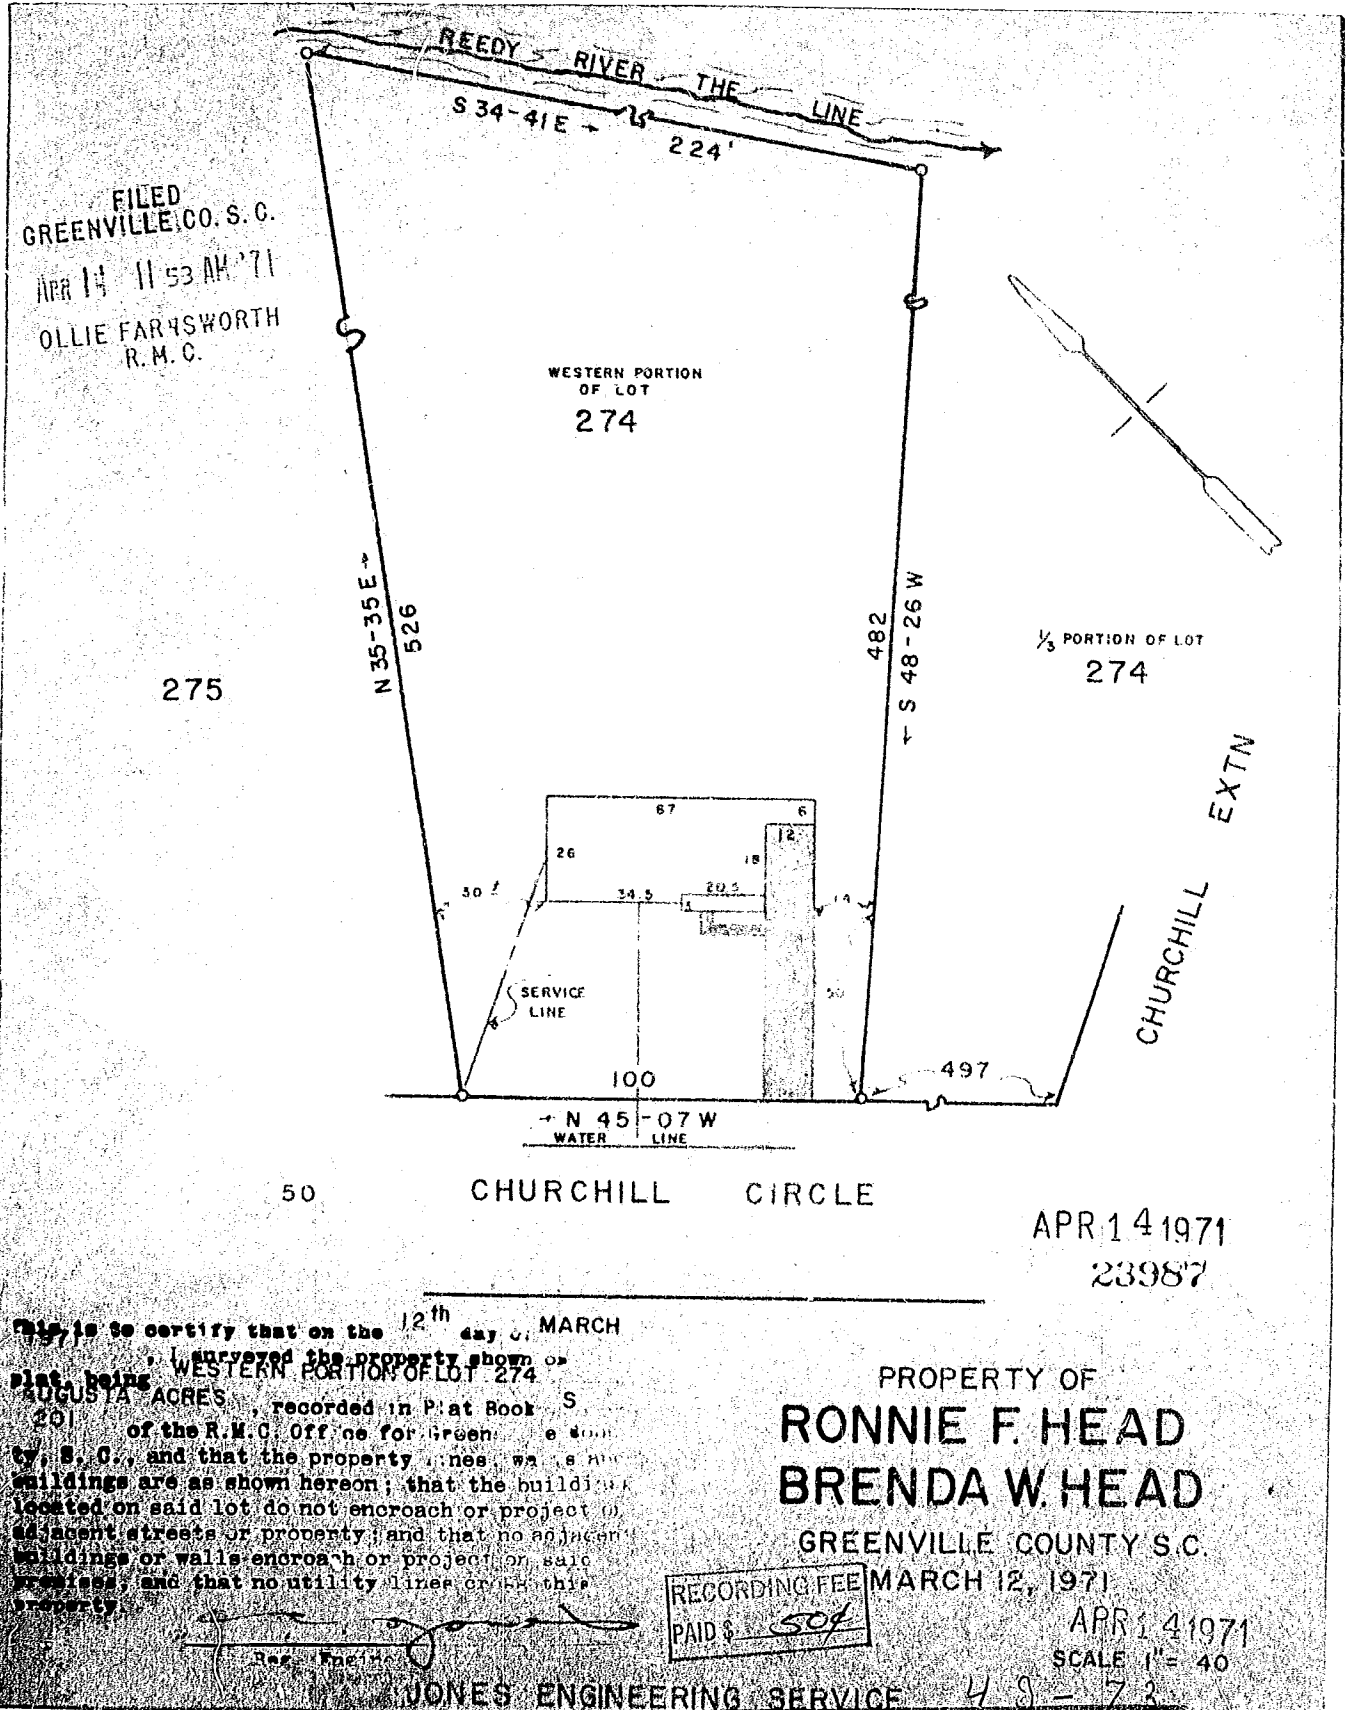

50 CHURCHILL CIRCLE APR 14 1971
 23987

This is to certify that on the 12th day of MARCH 1971, I surveyed the property shown on plat being WESTERN PORTION OF LOT 274 of AUGUSTA ACRES, recorded in Plat Book S 201 of the R.M.C. Office for Greenville County, S. C., and that the property lines and all buildings are as shown hereon; that the buildings located on said lot do not encroach or project on adjacent streets or property; and that no adjacent buildings or walls encroach or project on said premises; and that no utility lines cross this property.

PROPERTY OF
RONNIE F. HEAD
BRENDA W. HEAD
 GREENVILLE COUNTY S.C.

RECORDING FEE
 PAID \$ 50⁰⁰

APR 14 1971
 SCALE 1" = 40'

JONES ENGINEERING SERVICE 49-72

