


21774 Filed This 19 day of March 1971

And Recorded in Vol. 4 I Page 91 at 12:28 P.M.

Ollie Farnsworth

Register Messrs. Ollie Farnsworth, Greenville County, S.C.

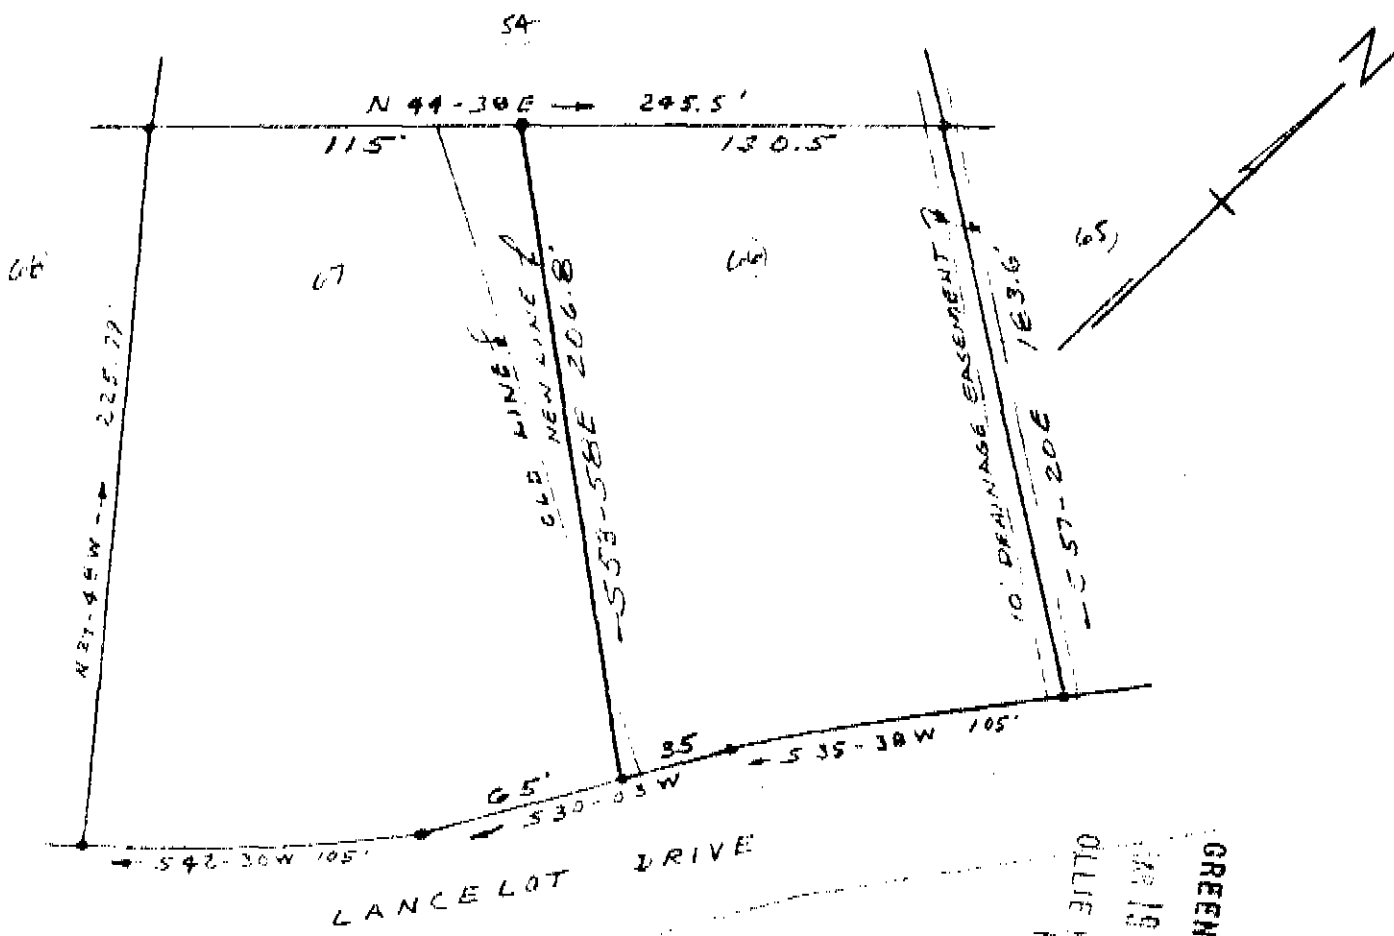

FILED  
 GREENVILLE CO. S.C.  
 MAR 19 12 28 PM '71  
 OLLIE FARNSWORTH  
 R.M.C.

REVISION  
 LOTS 66 & 67  
 CAMELOT  
 GREENVILLE CO., S.C.  
 MARCH 17, 1971 SCALE 1"=60'

THIS PLAT IS NOT A SUBDIVISION AS DEFINED BY THE GREENVILLE COUNTY SUBDIVISION REGULATIONS  
 3/19/71 *Don M. Wagoner* for  
 Chairman, Secretary, or Director  
 Planning  
 Greenville County Planning

4I-91 ✓

DRAWN BY CAMPBELL & CLARKSON  
 SURVEYORS, INC.  
 411 Bluebonnet Ave.  
 CHARLOTTE, N.C. 28209

REFERENCE:  
 PLAT BOOK WWW  
 PAGE 15 46 & 47

MAR 19 1971  
 21774