


23192 Filed This 6 day of April 1971
 And Recorded in Vol. 4 I Page 127 at 12:51 P.
 Ollie Farnsworth
 Register of Public Conveyance Greenville County, S. C.

RECORDING FEE
 PAID \$ 5.00

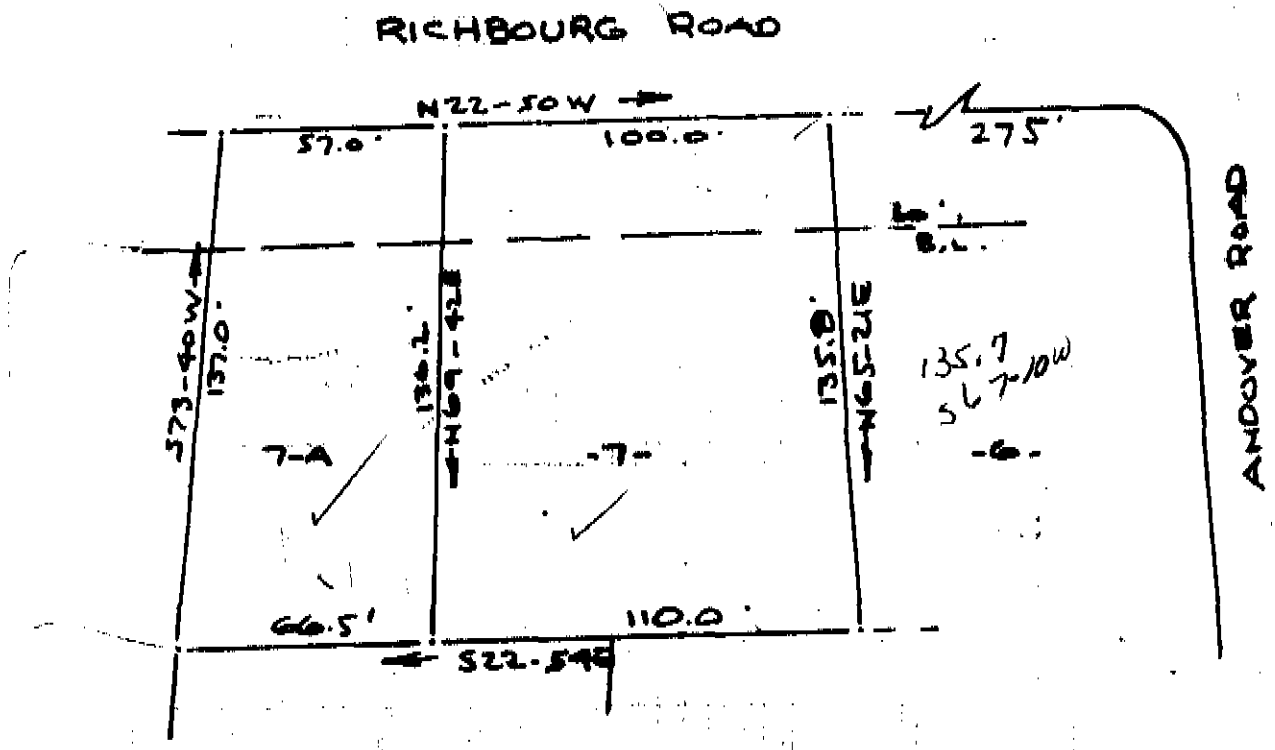

REVISION OF LOT 7 - SECTION 2 - HERITAGE HILL
 W. N. LESLIE, OWNER
 NEAR GREENVILLE, S. C.
 SCALE 1" = 50' JUNE 1968

FILED
 GREENVILLE CO. S. C.
 APR 6 12 51 PM '71
 OLLIE FARNSWORTH
 R.M.C.

APR 6 1971
 23192

49 - 127
 .50¢

CAROLINA ENGINEERING & SURVEYING CO
 GREENVILLE, S. C.