


23339 Filed This 7 day of April 1971
 And Recorded in Vol. 4 I Page 133 10:59 A
 Ollie Farnsworth
 Register Meane Conveyance Green Co. S. C.

PAID \$ 50

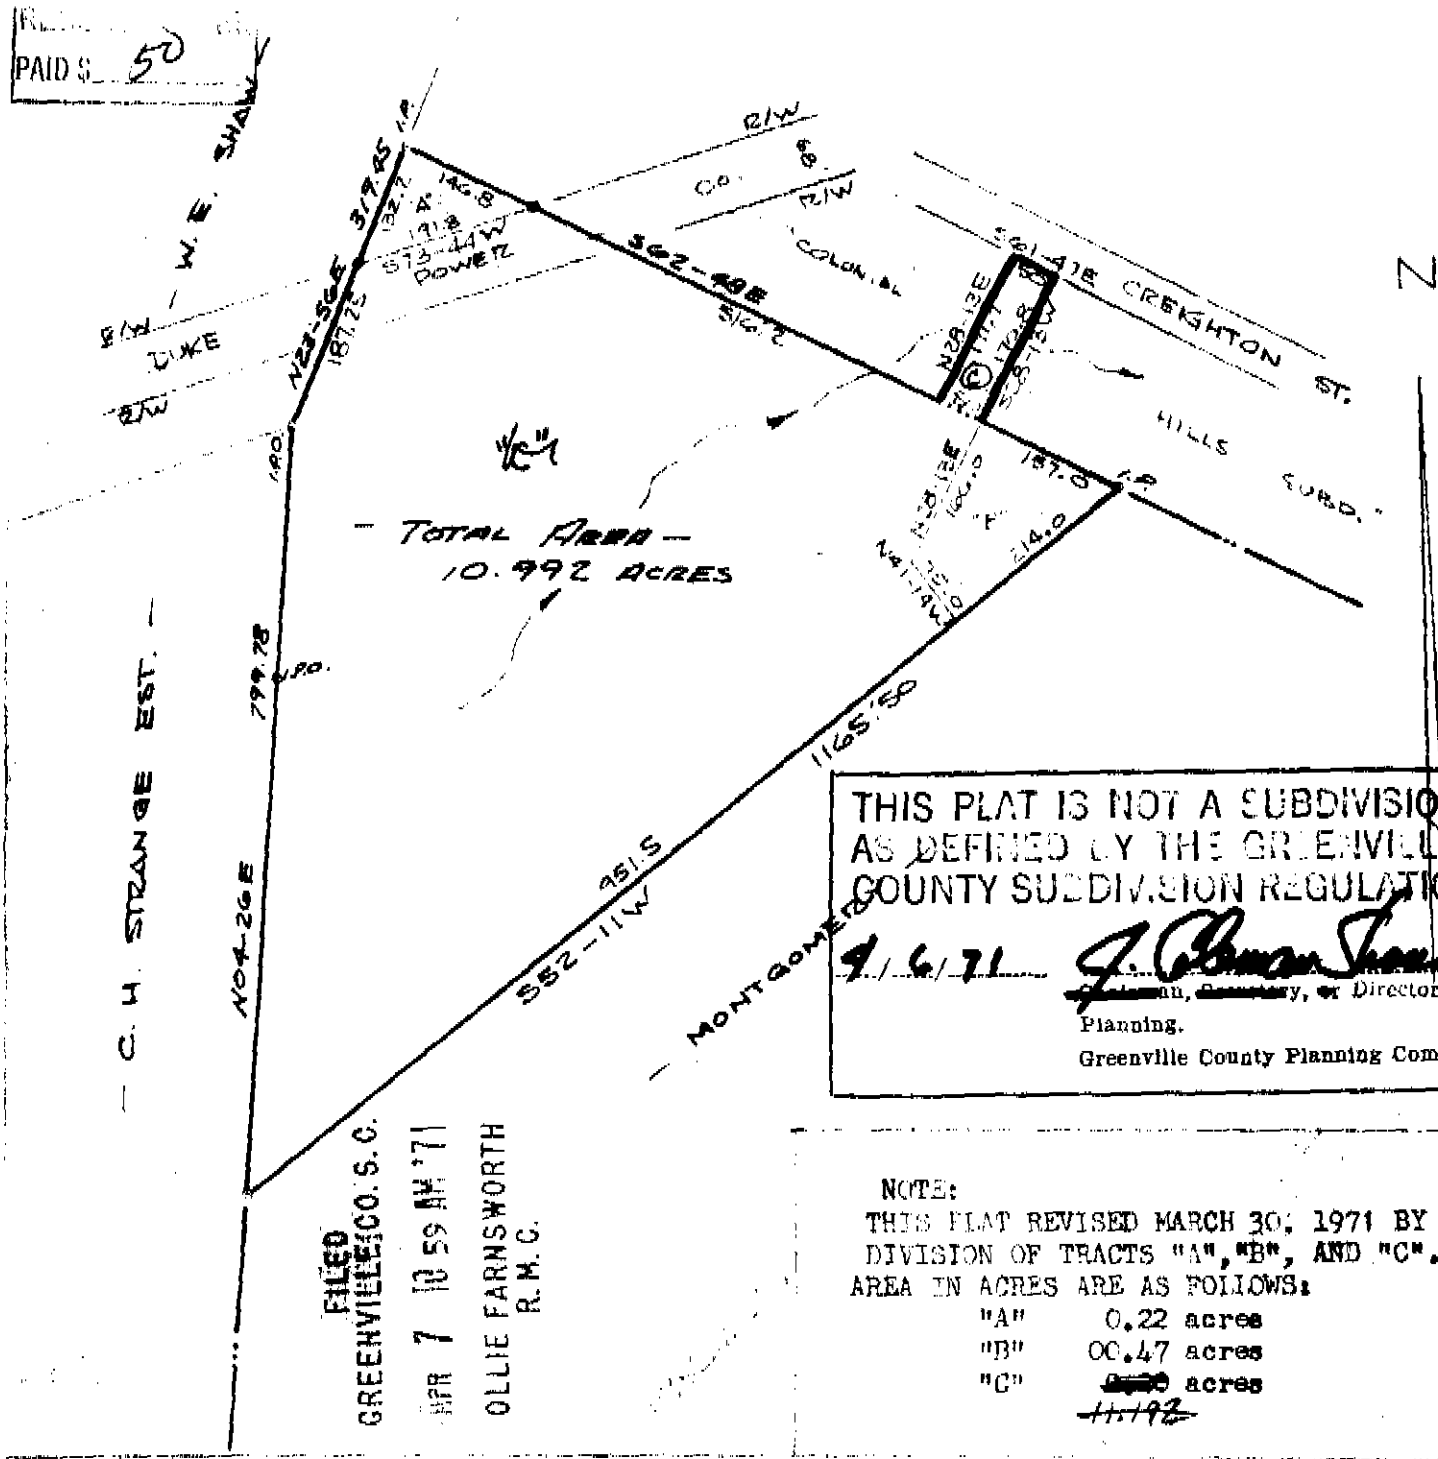

STATE OF SOUTH CAROLINA
 GREENVILLE COUNTY


APR 7 1971
 23339

PROPERTY OF MARSHALL MONTGOMERY AND HATTIE LEE
 MONTGOMERY. LOCATED NEAR THE CITY OF TAYLORS.

SURVEYED FEB. 15, 1971
 ROBERT R. SPEARMAN
 REG. L.S. NO. 3615

4 I - 133

SCALE 1" = 200'

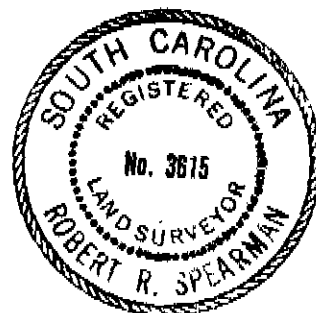

BRG 24