


#25531 Filed This 30 day of April 1971
 And Recorded in Vol. Y.F. Page 163 as 9:21 AM
 Ollie Farnsworth
 Registrar Greenville County, S. C.

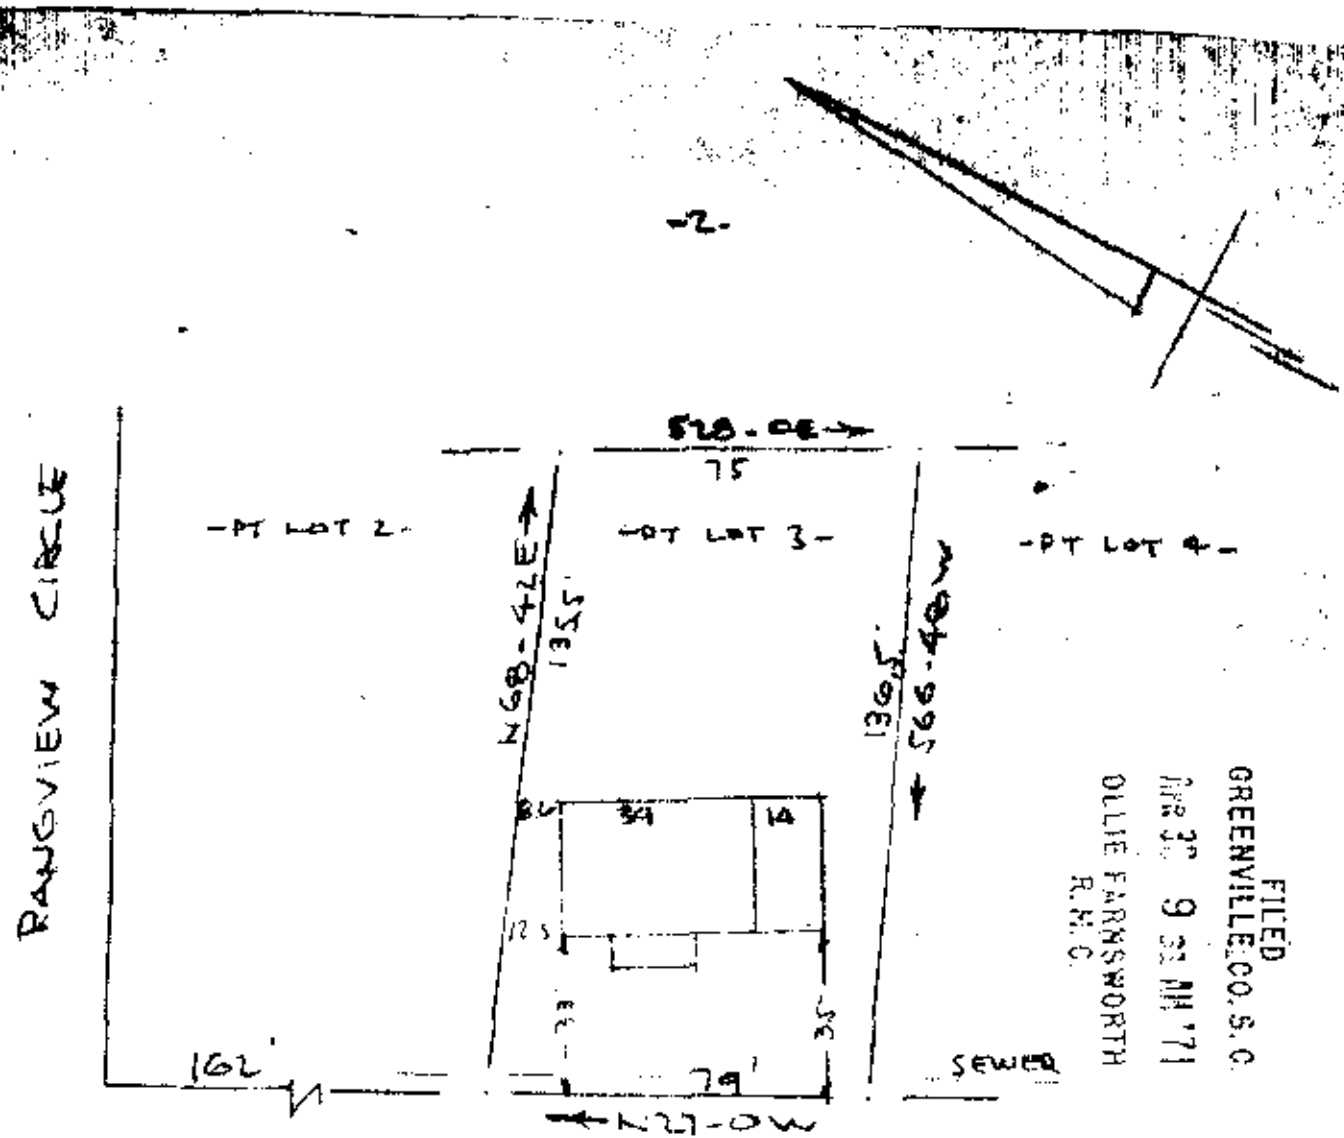

FILED
 GREENVILLE CO. S. C.
 APR 30 9 31 AM '71
 OLLIE FARNSWORTH
 R.M.C.

WHITE HORSE RD (HWY 123)
 WATER IN ST. R/W
 PROPERTY OF
 MEREDITH A. GENTRY & KAREN B. GENTRY
 NEAR GREENVILLE, S. C.
 SCALE: 1" = 40'
 22 APR 1971

This is to certify that on the 22nd day of April 1971, I surveyed the property shown on this plat, being known as part of lot 3 on plat of PROPERTY OF WILLIAM GREEN and recorded in the RMC Office Greenville County, S. C., in Plat Book "Y" at Page 96 and also being known as PROPERTY OF MEREDITH A. GENTRY & KAREN B. GENTRY and recorded in the RMC Office in Plat Book 4I at Page 163; and that the property lines, walls and buildings are as shown hereon, and that the walls and buildings located on said lot do not encroach or project on adjacent street or property, and that no adjacent walls or buildings encroach or project on said premises, and no power lines cross this property except as shown hereon.

H. B. Bruce, RLS1952

25531
 APR 30 1971

CAROLINA SURVEYING COMPANY
 Greenville, S. C.

REC
 504