


28553 Paid This 31 day of May 1971
 And Recorded in Vol. 4-I Page 195 at 2:21 PM

Ollie Farnsworth, S. C.

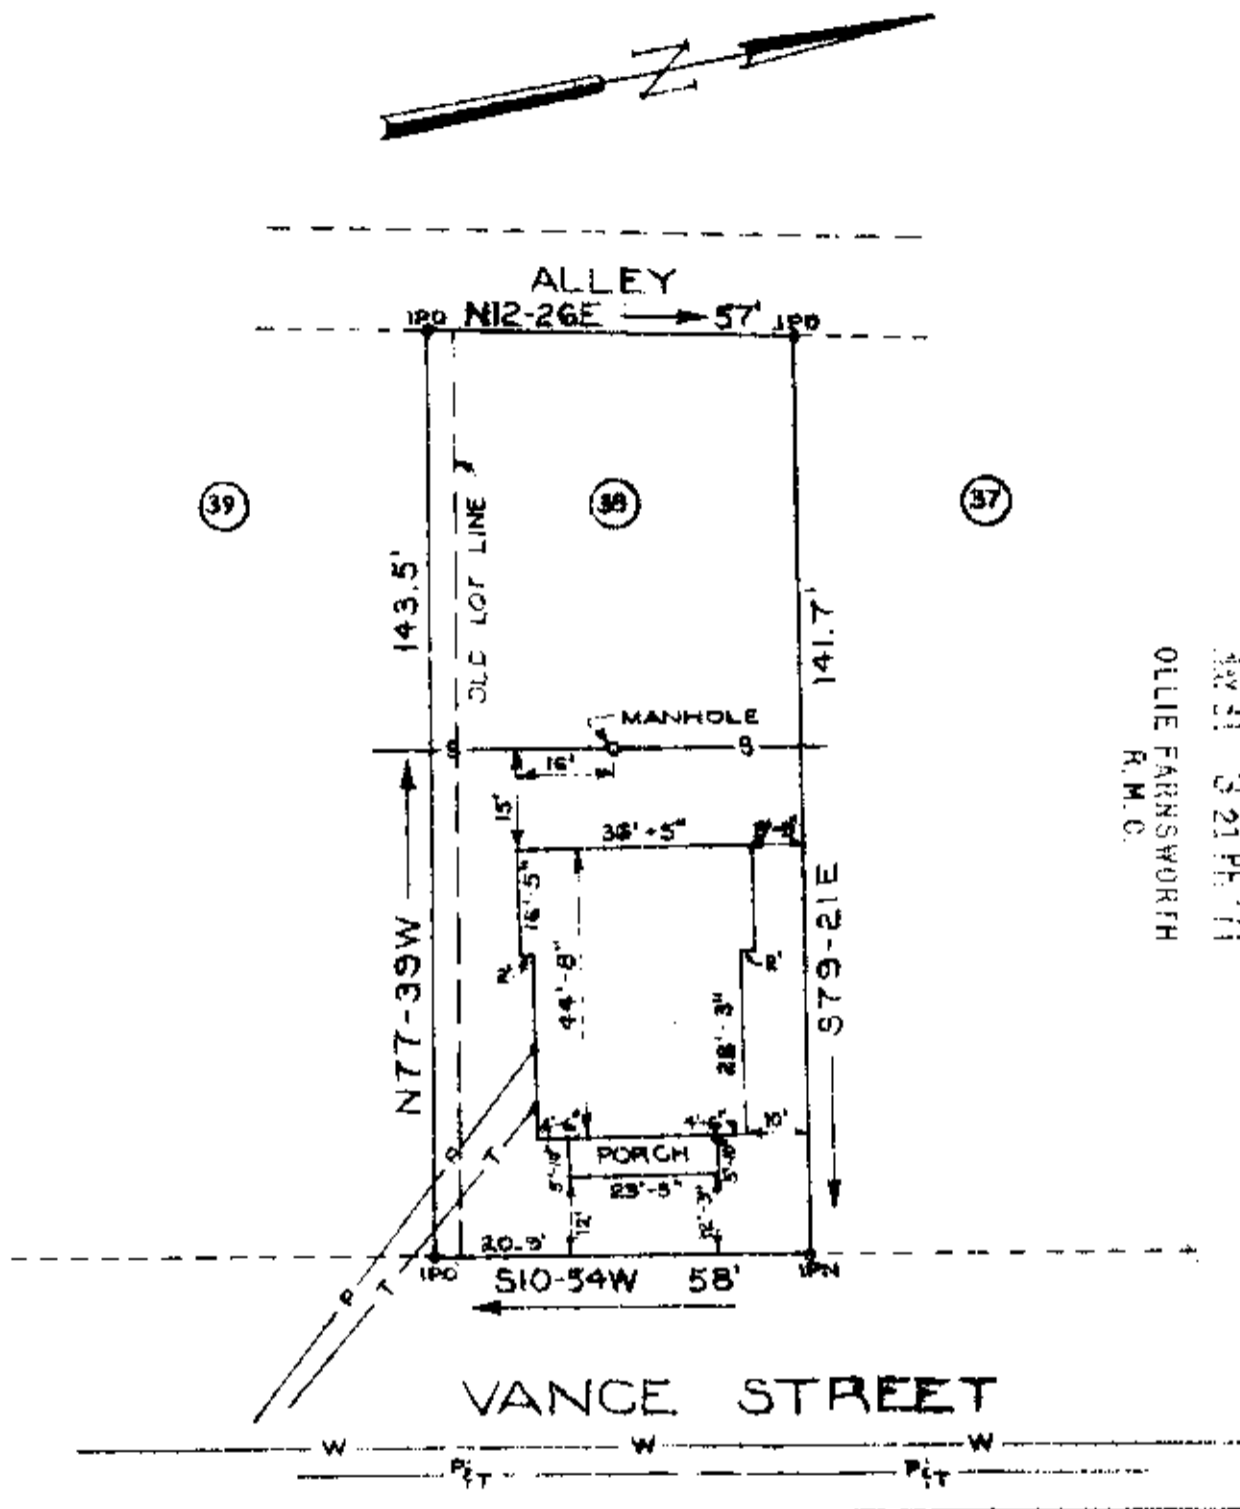

FILED
 GREENVILLE CO. S. C.
 MAY 31 3 21 PM '71
 OLLIE FARNSWORTH
 R.M.C.

REF. Plat Book 4-I
 Page 195

PLAT PROPERTY OF

JAMES W. HARVEY, JR & MARY A. HARVEY,

LOT 38 AND PART OF LOT 39
 GREENVILLE CO., S.C.
 SCALE: 1" = 30'

DATE: 5/13/71

28553

MAY 31 1971

RECORDED
 PAID \$50.00

This is to certify that on this date, the lot shown above was surveyed by me; and that property lines, walls, and buildings are as shown; that the buildings located on said property do not project or encroach on adjacent streets or property; and that no adjacent buildings or walls encroach or project on said premises. No utility lines cross this property except as shown.

William R. McCoy
 William R. McCoy
 Reg. Engr. & L. S. #3551

4 I - 195

mwright associates
 GREENVILLE, S. C.