


MICROFILMED

RECORDING FEE
PAID \$ 150

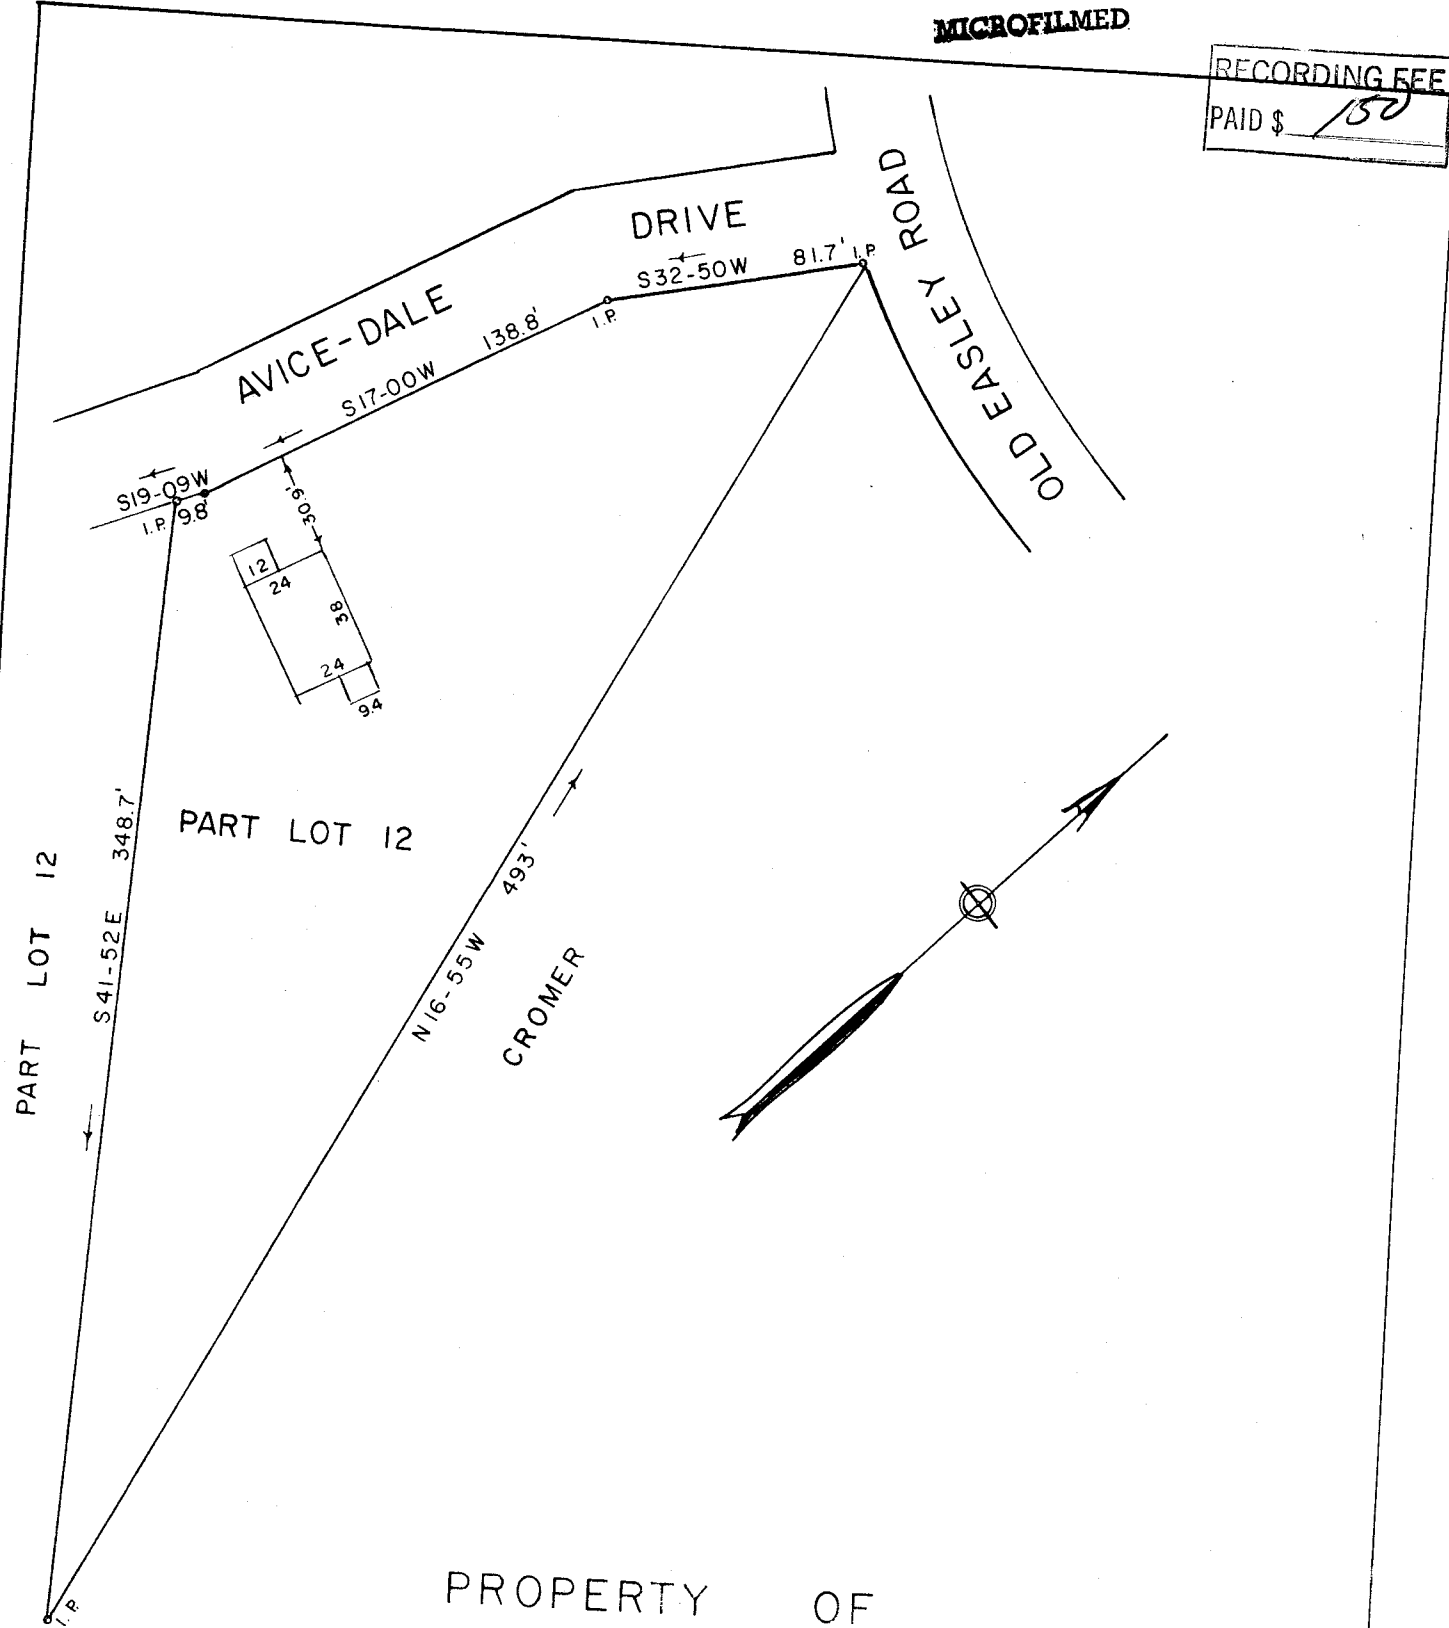

PROPERTY OF
E. DELL McCALL

MAY 9 - 1972 30390 ✓

GREENVILLE CO., S. C.

Scale 1" = 60'

May, 1972

45-175-A

This is to certify that on the 5th day of May, 1972, we surveyed the property shown on this plat; being known as part of Lot 12 on plat of Avice-Dale, Recorded in Plat Book B page 53, Office of R. M. C. Greenville Co., S. C.; and that the property lines, walls and buildings are as shown hereon; that the buildings located on said lot do not encroach or project on adjacent streets or property; and that no adjacent buildings or walls encroach or project on said premises.

R. W. Dalton
Dalton & Neves Co., Engineers