


28279 Filed This 25 day of May 1971
 and Recorded in Vol. 44 Page 7 at 3:28 PM
 Ollie Farnsworth
 Register of Deeds Greenville County, S. C.

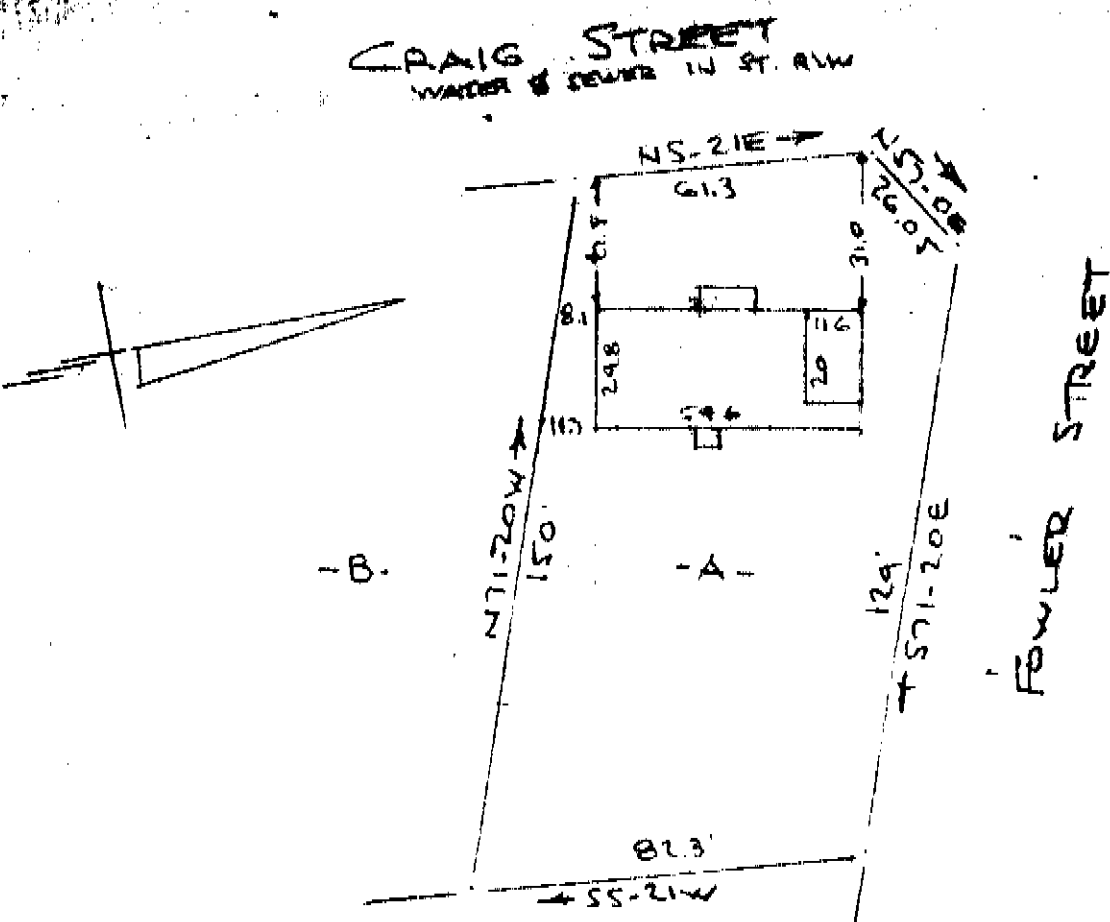

- J. C. DRUMMOND -

FILED
 GREENVILLE CO. S. C.
 MAY 25 3 28 PM '71
 OLLIE FARNSWORTH
 R.M.C.

PROPERTY OF SARAH LOUISE DAY
 FOUNTAIN INN, S. C. - GREENVILLE CO
 SCALE 1" = 40' 17 MAY 1971

This is to certify that on the 17th day of May 1971, I surveyed the property shown on this plat, being known as lot A on plat of PROPERTY OF SARAH LOUISE DAY and recorded in the RMC Office Greenville County, S.C., in Plat Book 4 K at Page 7; and that the property lines, walls and buildings are as shown hereon, and that the walls and buildings located on said lot do not encroach or project on adjacent street or property, and that no adjacent walls or buildings encroach or project on said premises, and no power lines cross this property except as shown hereon.

R. B. Bruce
 R. B. Bruce, RLS.#1252

MAY 25 1971

28279

FILED
 504

Carolina Surveying Company
 Greenville, S. C.