


29868 Filed This 9 day of June 1971
 And Recorded in Vol. 4K Page 41 at 2:48 PM

Ollie Farnsworth
 Registrar of Deeds, Greenville County, S. C.

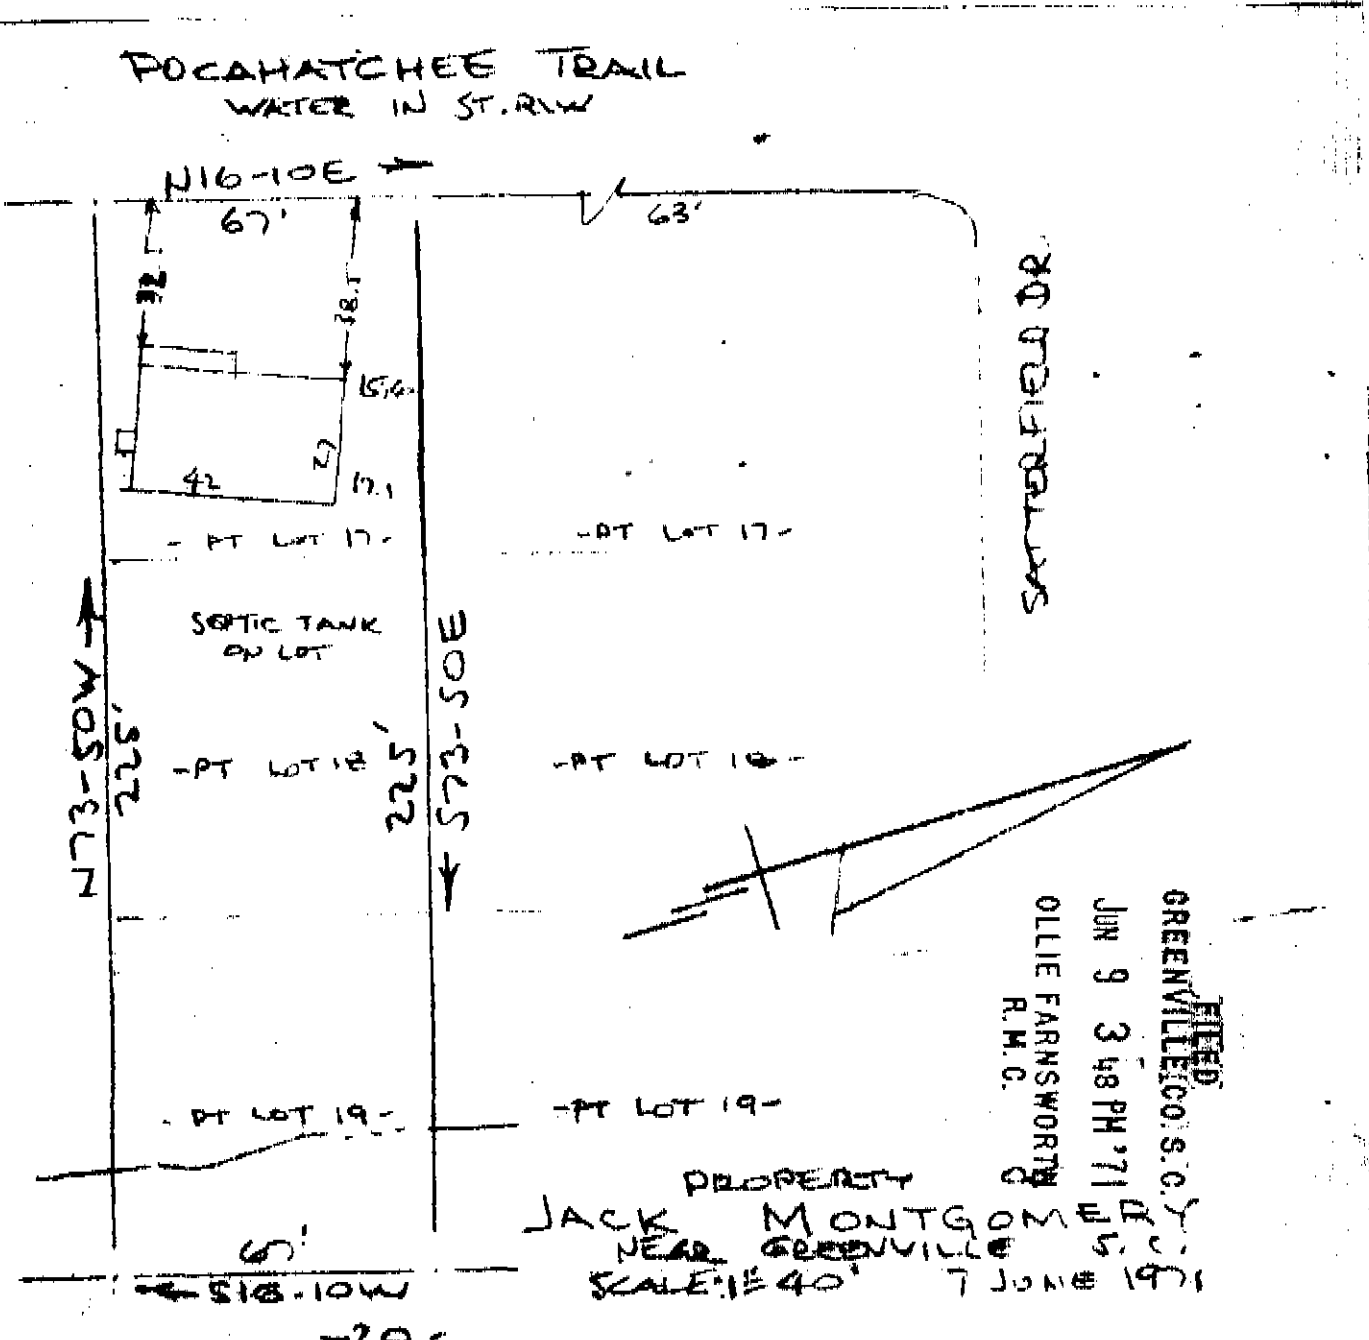

FILED
 GREENVILLE CO. S.C.
 JUN 9 3 48 PM '71
 OLLIE FARNSWORTH
 R.M.C.
 7 JUNE 1971

This is to certify that on the 7th day of June 1971, I surveyed the property shown on this plat, being known as part of lot 17, part of lot 18 and part of lot 19 on plat of PROPERTY OF JACK MONTGOMERY and recorded in the RMC Office Greenville County, S.C., in Plat Book 4K at Page 41; and that the property lines, walls and buildings are as shown hereon, and that the walls and buildings located on said lots do not encroach or project on adjacent street or property, and that no adjacent walls or buildings encroach or project on said premises, and no power lines cross this property except as shown hereon.

R. B. Bruce
 R. B. Bruce, RLS #1952

RECORDING FEE
 \$50.00

JUN 9 1971
 29868

CAROLINA SURVEYING COMPANY
 Greenville, S. C.