


32033 Filed This 30 day of June 1971
 And Recorded in Vol. 4K Page 73 at 10:42 A.

Ollie Farnsworth
 Registrar of Deeds, Greenville County, S. C.

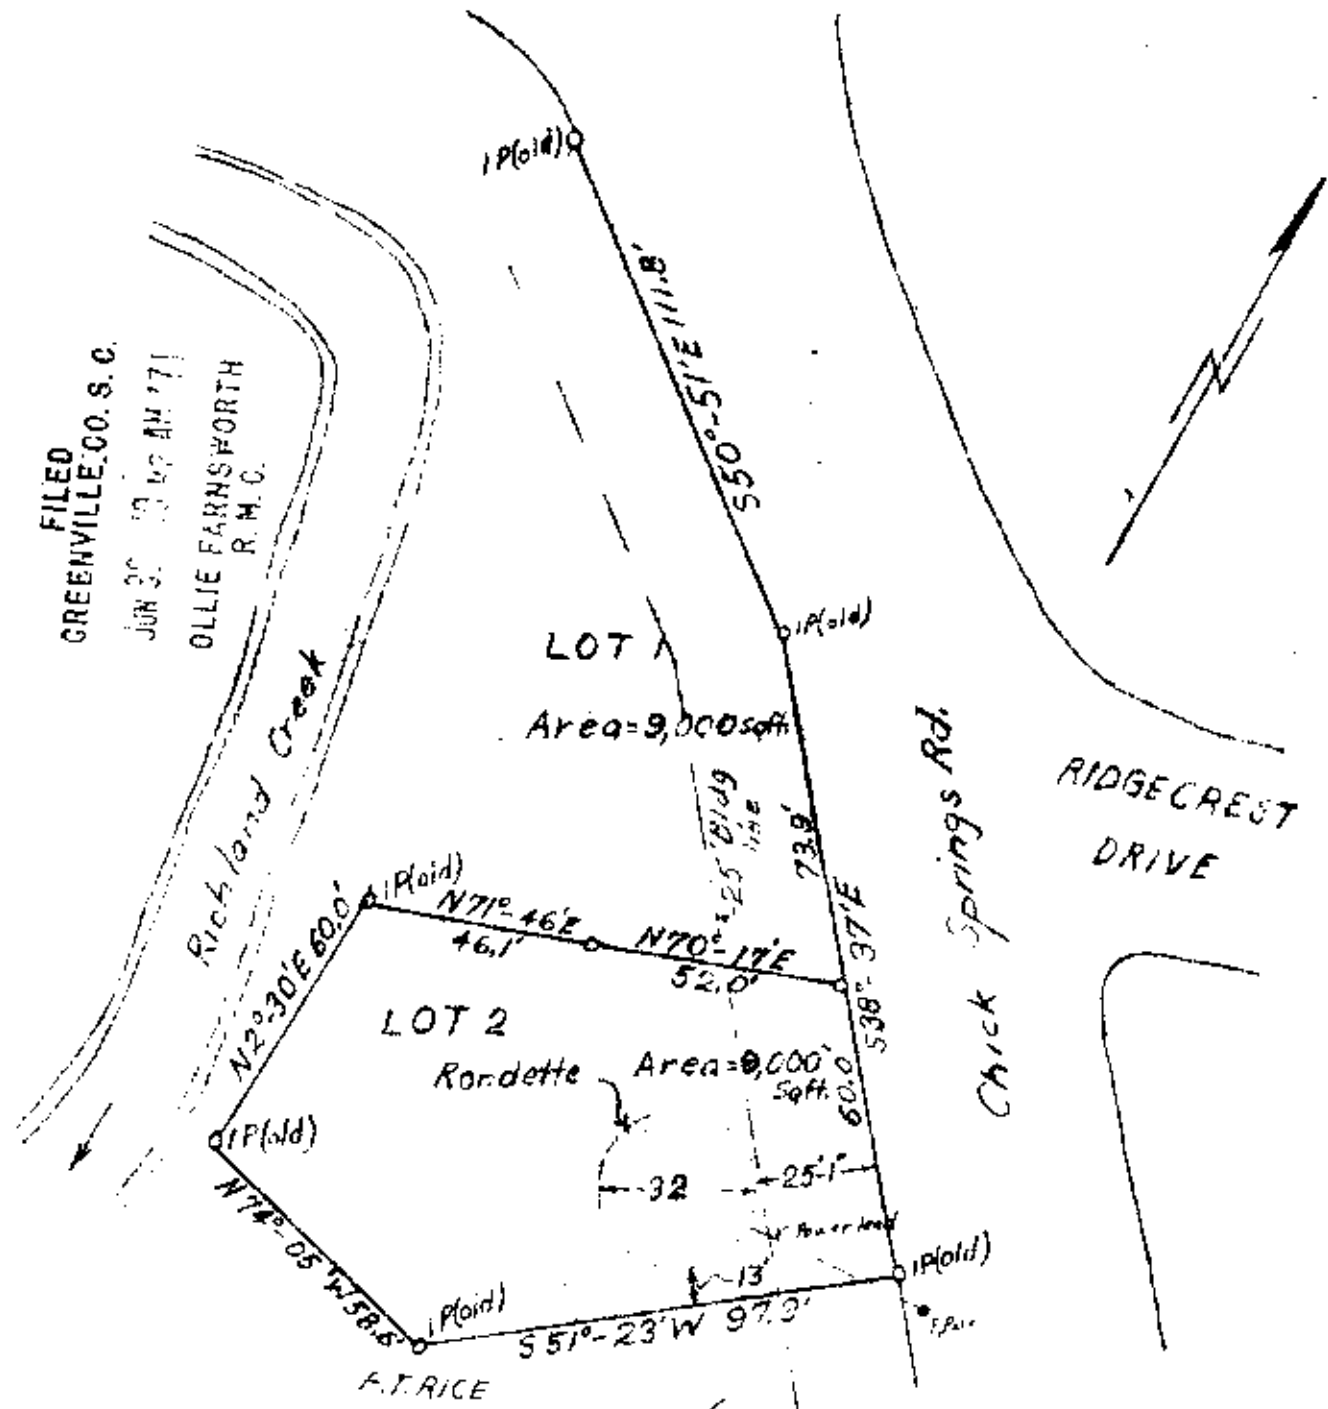

FILED
 GREENVILLE, CO. S. C.
 JUN 30 10 42 AM '71
 OLLIE FARNSWORTH
 R. M. C.

This is to certify that on June 2, 1971 I surveyed the lots shown above for F.T. Rice and all lines, walls, and buildings are as shown and no adjacent buildings encroach on said property lines. Located in Greenville, Greenville County S.C. Scale 1"=40' 32033

Alex A. Moss Reg. C.E. & L.S. No. 1194

Alex A. Moss

JUN 30 1971

506

4K-73