5324 Filed This 20 day of Aug 1971
And Recorded in Vol. 4K Page 191 at 11:31 A.M.
Clerk of Court
Register Mesne Conveyances Greenville County, S. C.

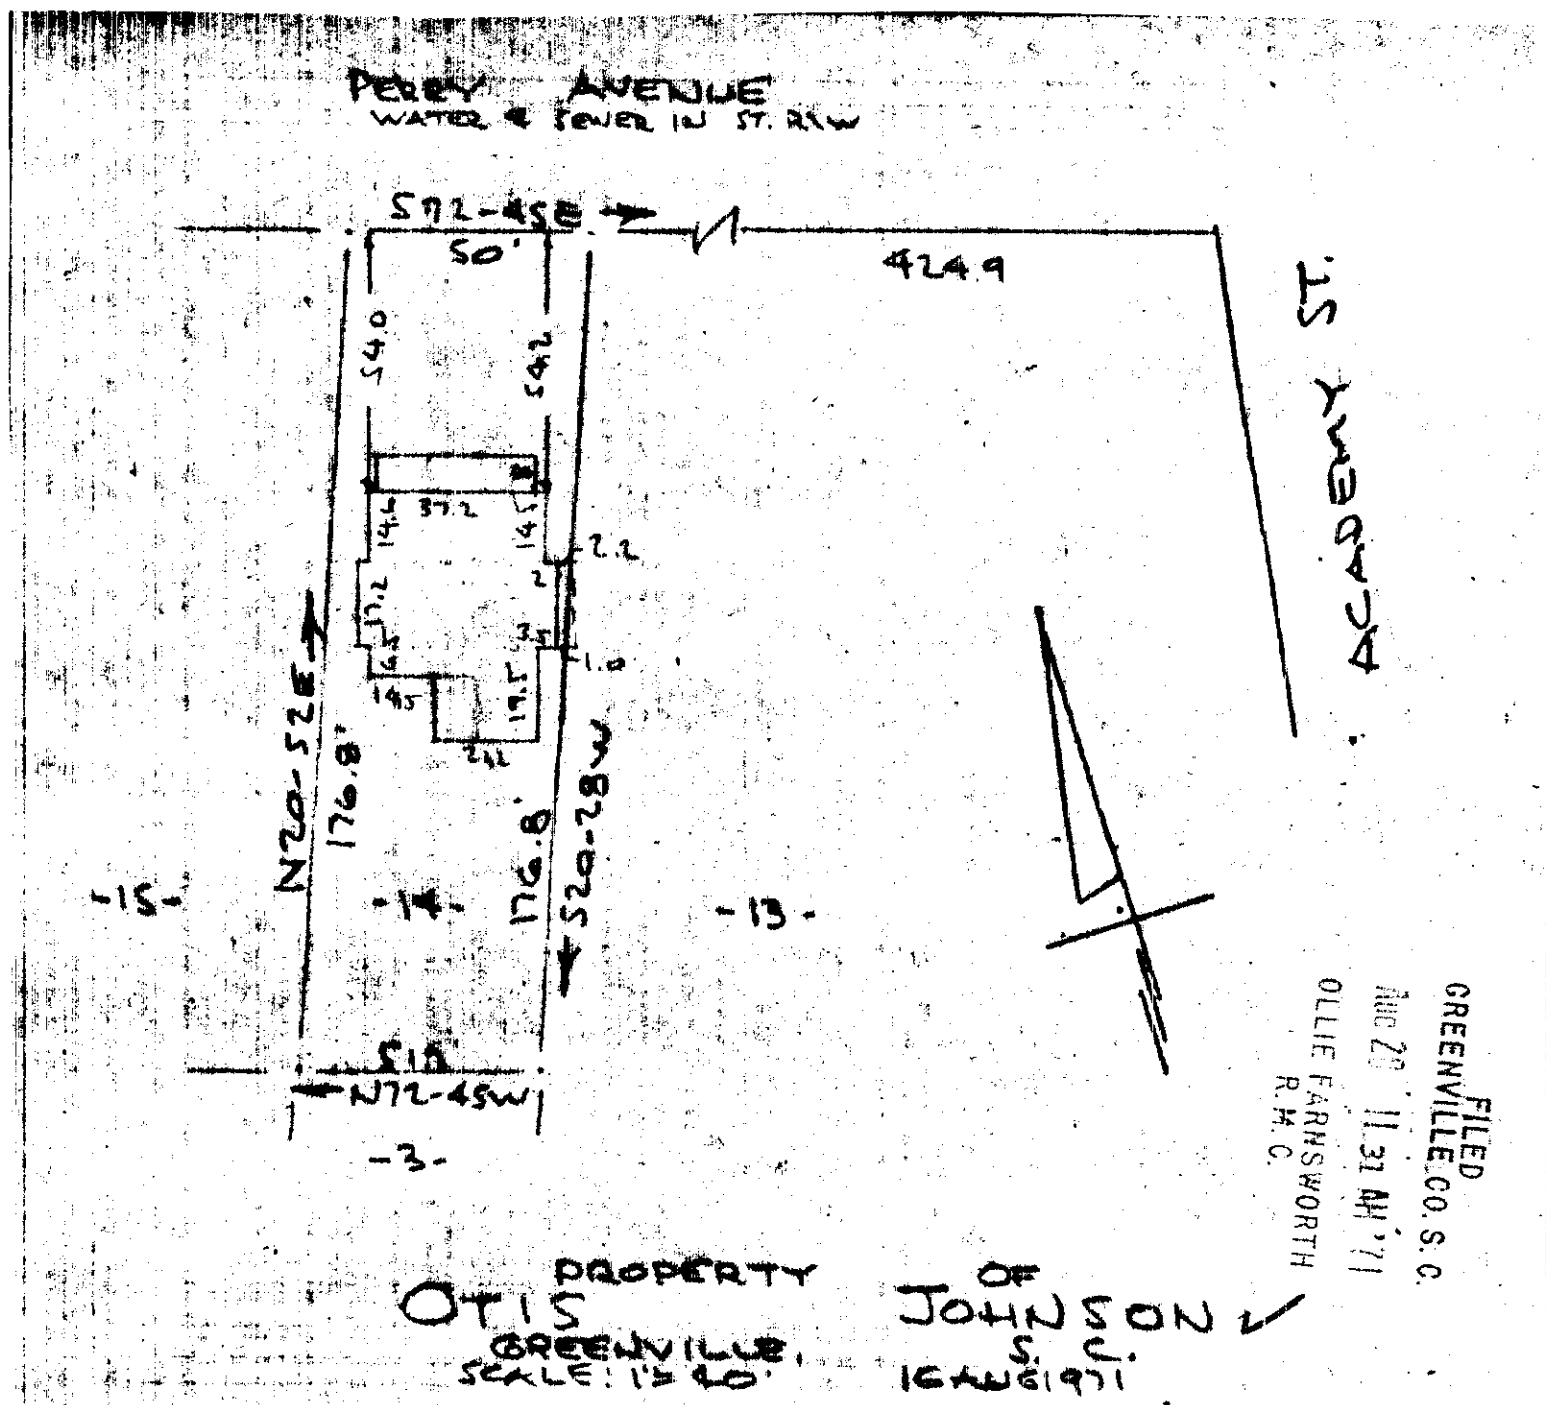

PROPERTY OF
OTIS JOHNSON
GREENVILLE, S.C.
SCALE: 1" = 40'
16 AUG 1971

This is to certify that on the 16th day of August 1971, I surveyed the property shown on this plat, being known as lot 14 on plat of PROPERTY OF OTIS JOHNSON and recorded in the RMC Office Greenville County, S.C., in Plat Book 4K at Page 191 ; and that the property lines, walls and buildings are as shown hereon, and that the walls and buildings located on said lot do not encroach or project on adjacent street or property, and that no adjacent walls or buildings encroach or project on said premises, and no power lines cross this property except as shown hereon.

RECORDING FEE
PAID $ 50¢

4K-191 5324
AUG 20 1971

R. B. Bruce
R. B. Bruce, RLS #1952

CAROLINA SURVEYING COMPANY
Greenville, S. C.