


21600  
 And Recorded in Vol 4M p 113 24/12/72  
 Register Map of Greenville Co. S.C.

MICROFILMED

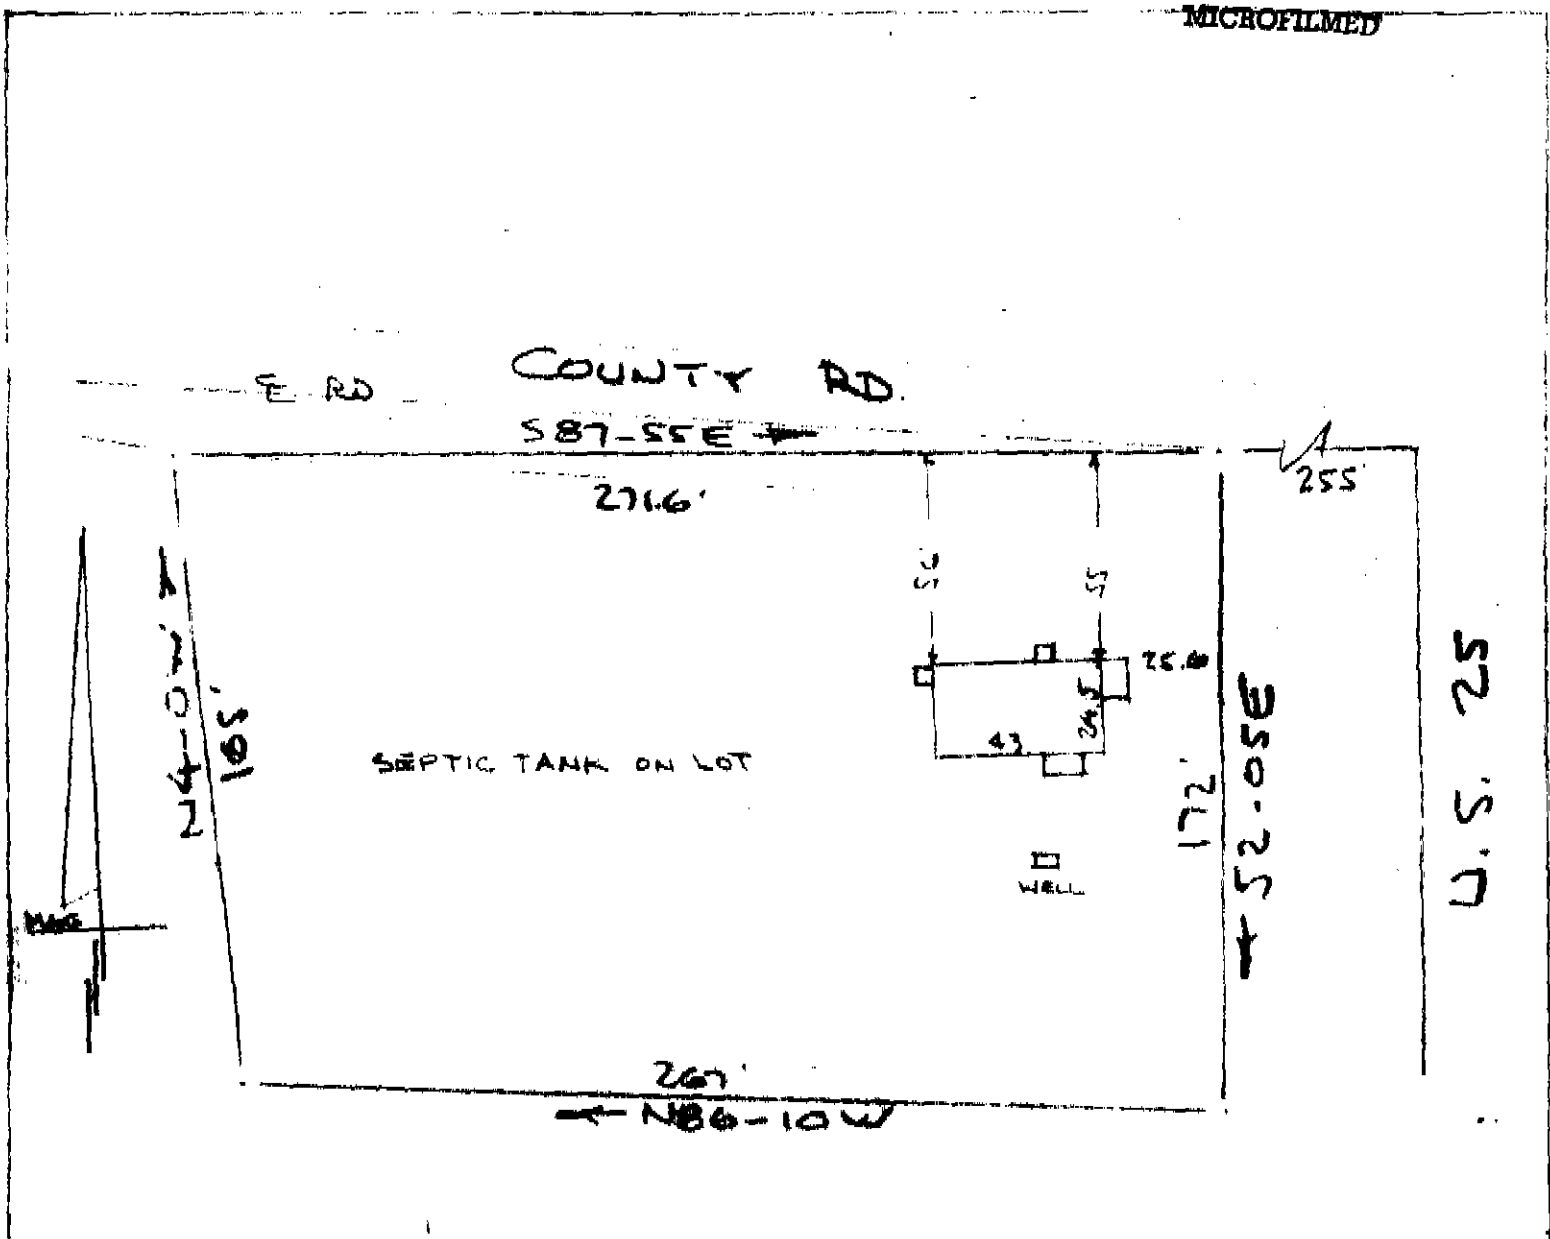

PROPERTY OF  
**BOBBY MICHAEL COLLINS**  
 NEAR GREENVILLE, S.C.  
 SCALE: 1" = 50' 29 NOV 1971

This is to certify that on the 29th day of November 1971, I surveyed the property shown on this plat, being known as PROPERTY OF BOBBY M. COLLINS and recorded in the RMC Office Greenville County, S.C., in Plat Book 4-M at Page 113; and that the property lines, walls and buildings are as shown hereon, and that the walls and buildings located on said property do not encroach or project on adjacent street or property, and that no adjacent walls or buildings encroach or project on said premises, and no power lines cross this property except as shown hereon.

FILED  
 GREENVILLE CO. S.C.  
 FEB 10 4 12 PM '72  
 OLLIE FARNSWORTH  
 R.M.C.

21600 ✓  
 FEB 10 1972 4M-113

R. B. Bruce  
 R. B. Bruce, RLS #1952

CAROLINA SURVEYING COMPANY  
 112 Manly Street

RECORDING FEE  
 PAID \$ 50