


24326 13 March 1972  
 And Recorded in Vol. 4M-157 p. 10, 53 A.  
 Registrar of Deeds Greenville County, S.C.

FILED  
 24-301410

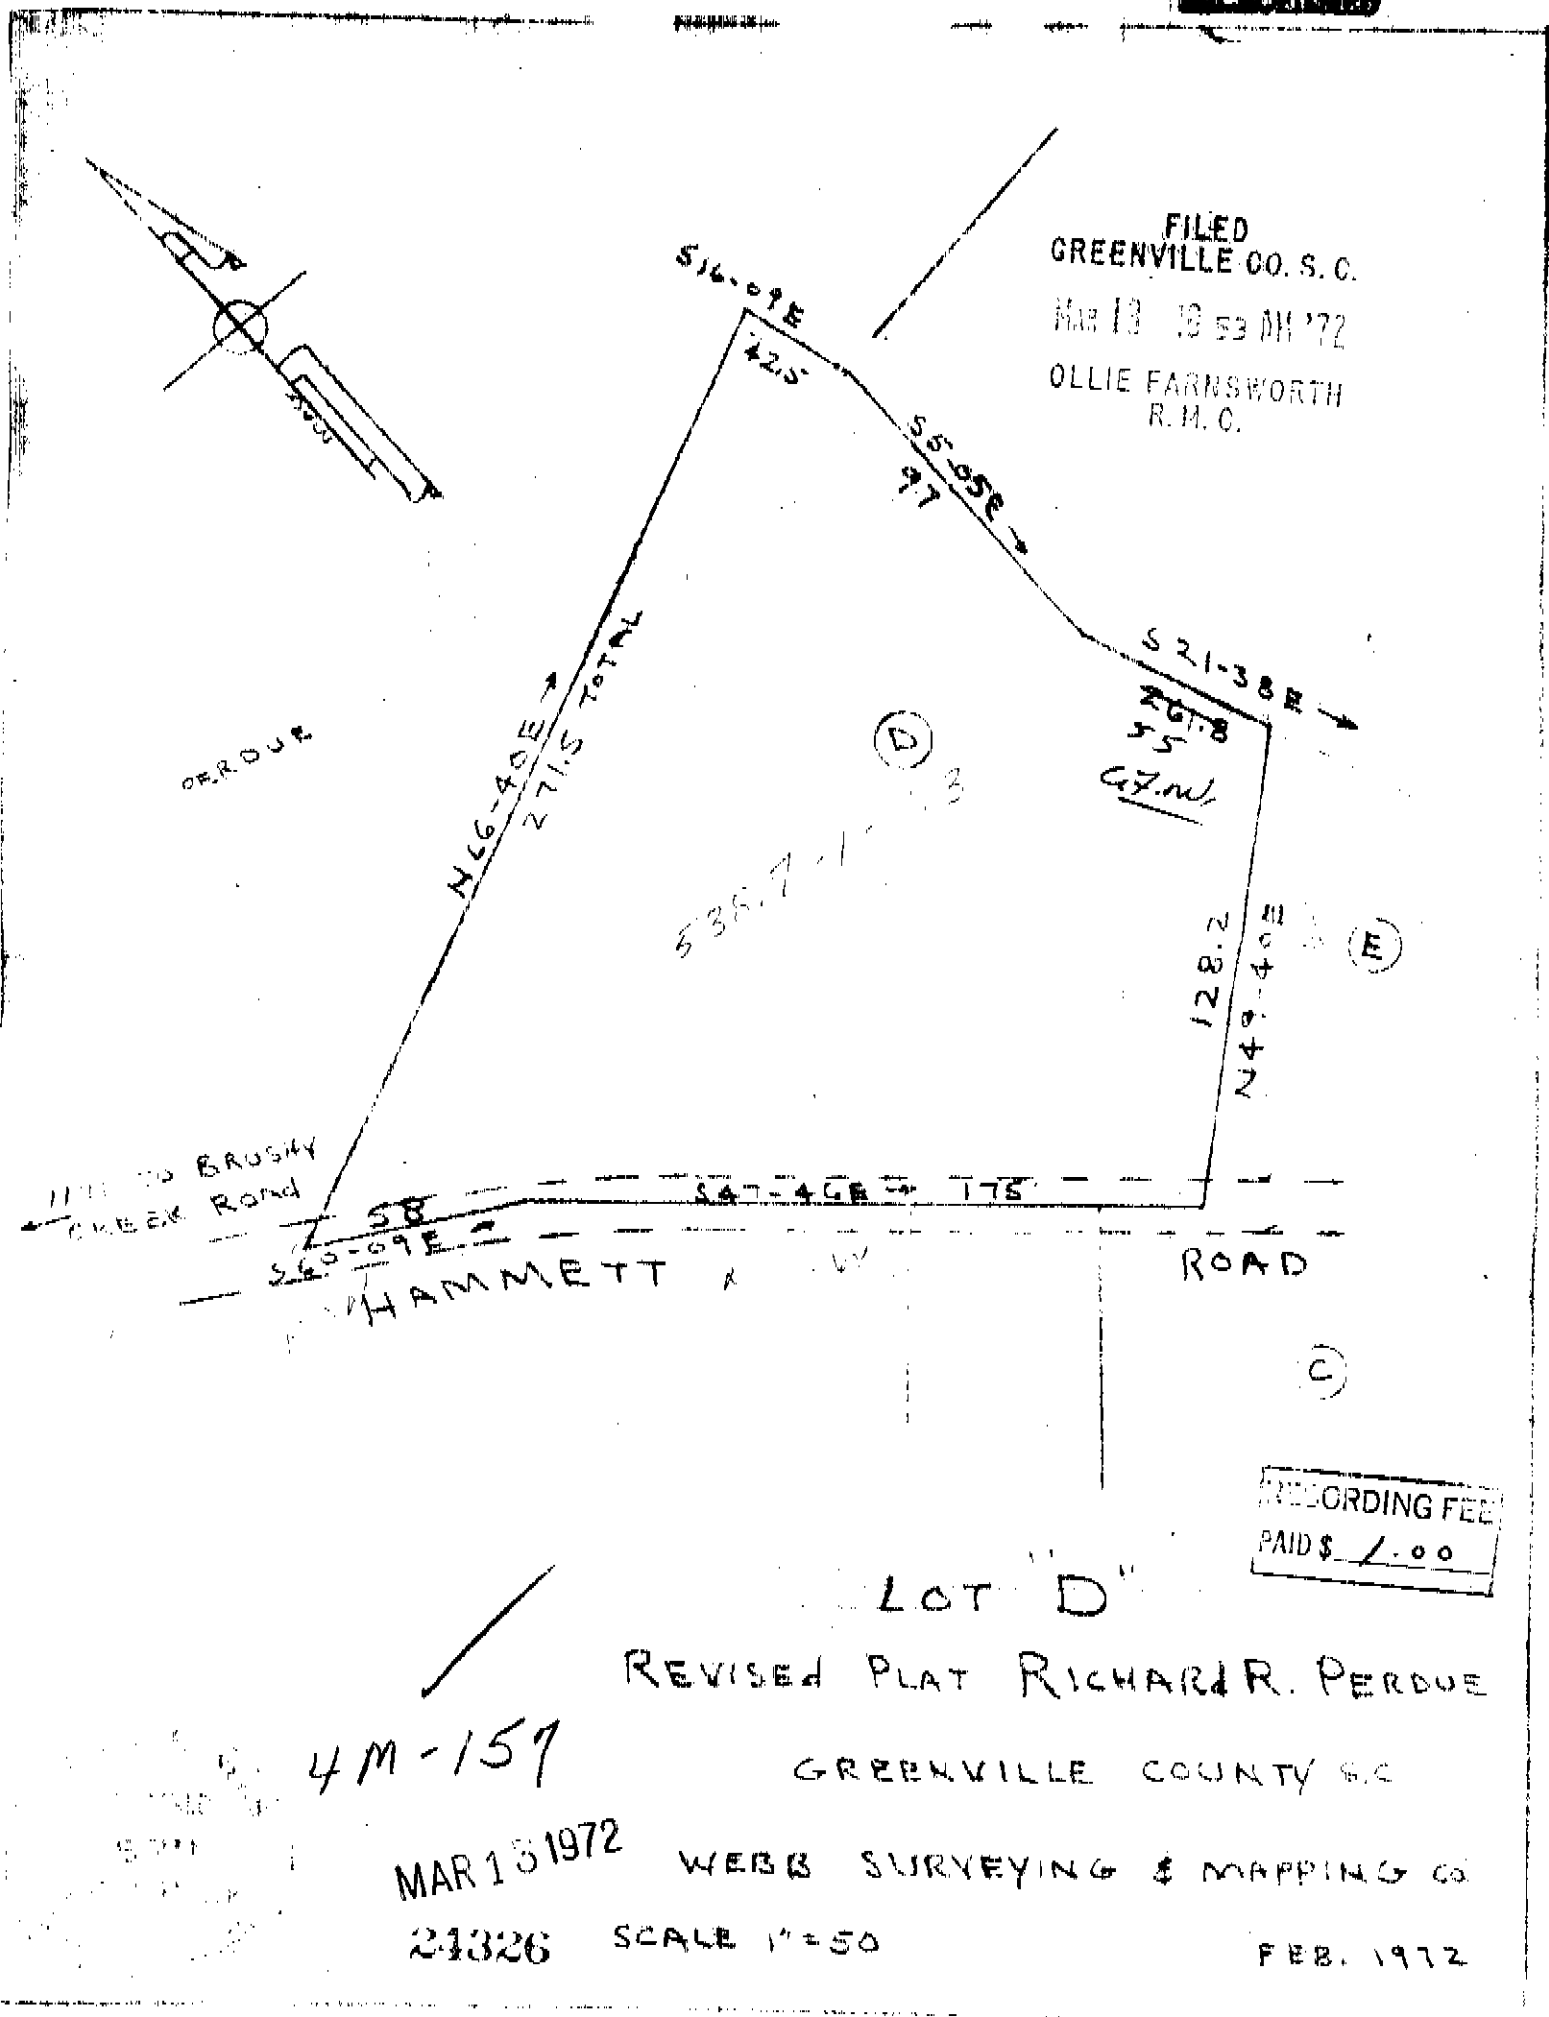

RECORDING FEE  
 PAID \$ 1.00

LOT "D"

REVISED PLAT RICHARD R. PERDUE

GREENVILLE COUNTY S.C.

4M-157

MAR 15 1972

WEBB SURVEYING & MAPPING CO.

24326 SCALE 1"=50

FEB. 1972