


MICROFILMED

4-0-113

RECORD  
BOOK 133  
PAGE 10


FILED  
GREENVILLE CO. S. C.  
Apr 11 4 50 PM '74  
BONNIE S. TANKERSLEY  
R.M.C.

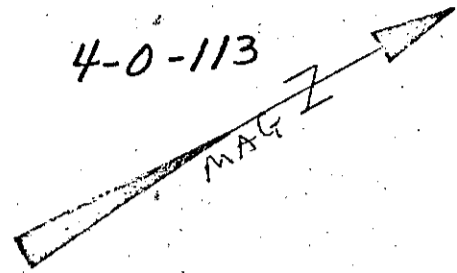

AMERICAN LEGION ROAD

← 0.5 MI. TO GRAYLEY STREET

34

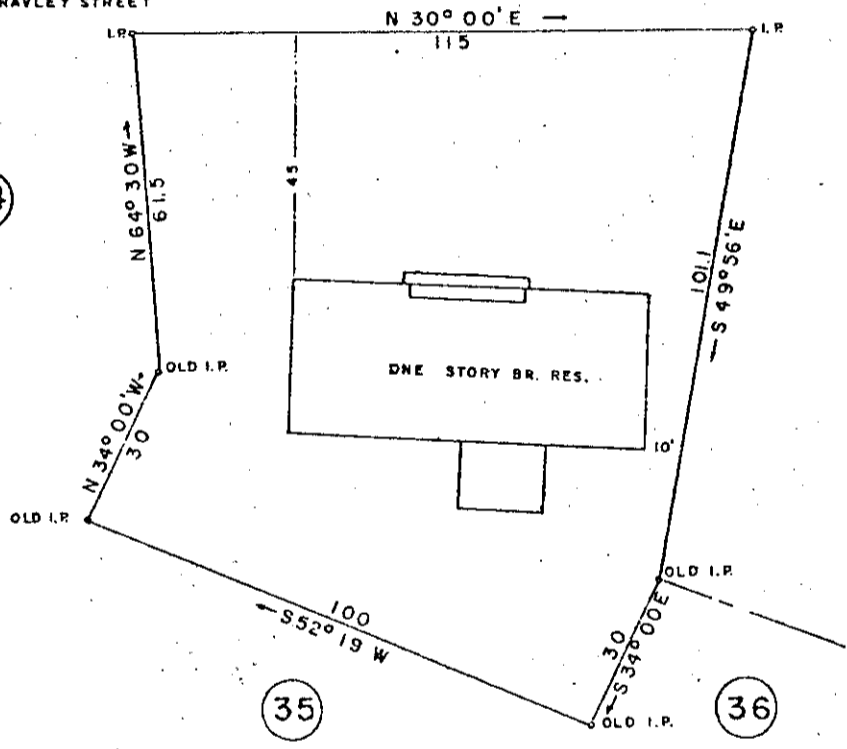

35

36

APR 1 1974


PROPERTY OF  
**JACOB R. & ROSEMARY PRUITT**

25585

GREENVILLE COUNTY SOUTH CAROLINA  
SCALE 1" = 30'  
SURVEYED MARCH 19, 1974

THIS IS TO CERTIFY THAT ON THIS DATE I SURVEYED THE PROPERTY SHOWN HEREON AND THE LINES ARE AS SHOWN, THAT THE BUILDINGS OR WALLS DO NOT ENCRUMB ON ADJOINING PROPERTY, AND THAT THE (LINES) OF ADJACENT PROPERTY DO NOT ENCRUMB ON THIS EXCEPT AS SHOWN

PLAT BOOK REF 5304 392 PAGE 328 DEED REF BOOK PAGE

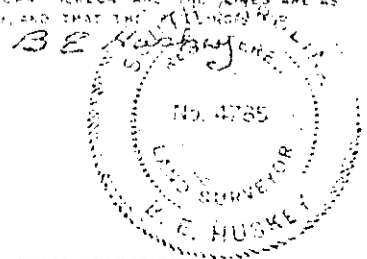

WOLFE & HUSKEY, INC.  
ENGINEERING AND SURVEYING  
LAWSON, S. C.

BEING PART OF LOT 230 33  
SURVEY BY J.G. DRUCE

RECORDED APR 11 1974

A-745