


4-0-174



R/W

STATE PARK ROAD

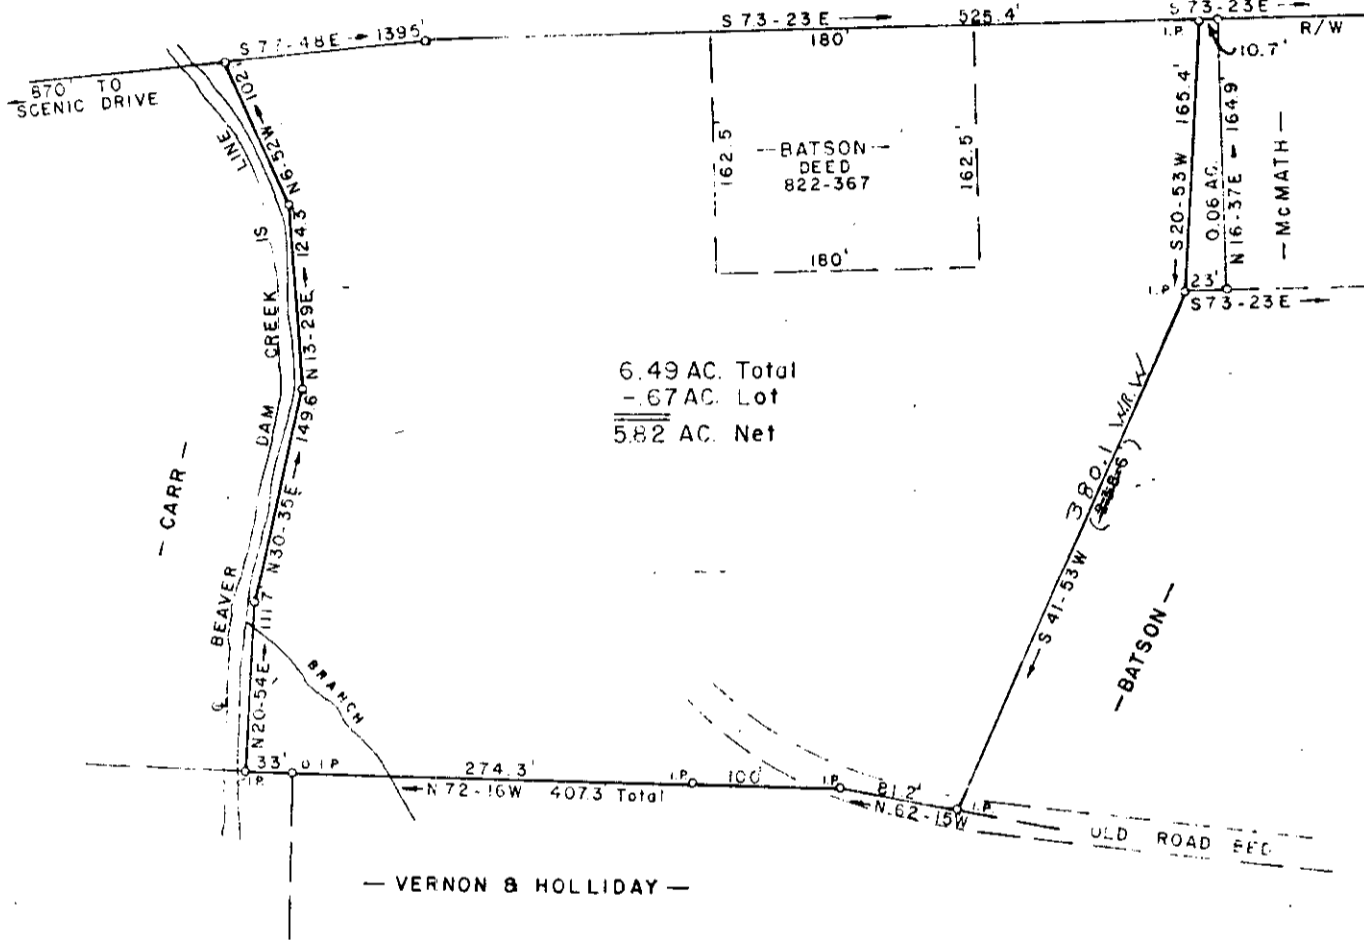

6.49 AC. Total  
 - 67 AC. Lot  
 5.82 AC. Net

PROPERTY OF  
 HAROLD BATSON  
 CAROLYN B. BATSON  
 NEAR TRAVELERS REST GREENVILLE CO.  
 SOUTH CAROLINA  
 SEPT. 6, 1974

FILED  
 GREENVILLE CO. S.C.  
 OCT 25 10 50 AM '74  
 DONNIE S. TANKERSLEY  
 R.M.C.



W R WILLIAMS, JR ENGR / SURVEYOR # 3979  
 15 SOUTH MAIN STREET  
 TRAVELERS REST, S.C.

OCT 25 1974

10782

RECORDING FEE  
 PAID \$2.50

140-174

SCALE 1" = 100'

202

photo