
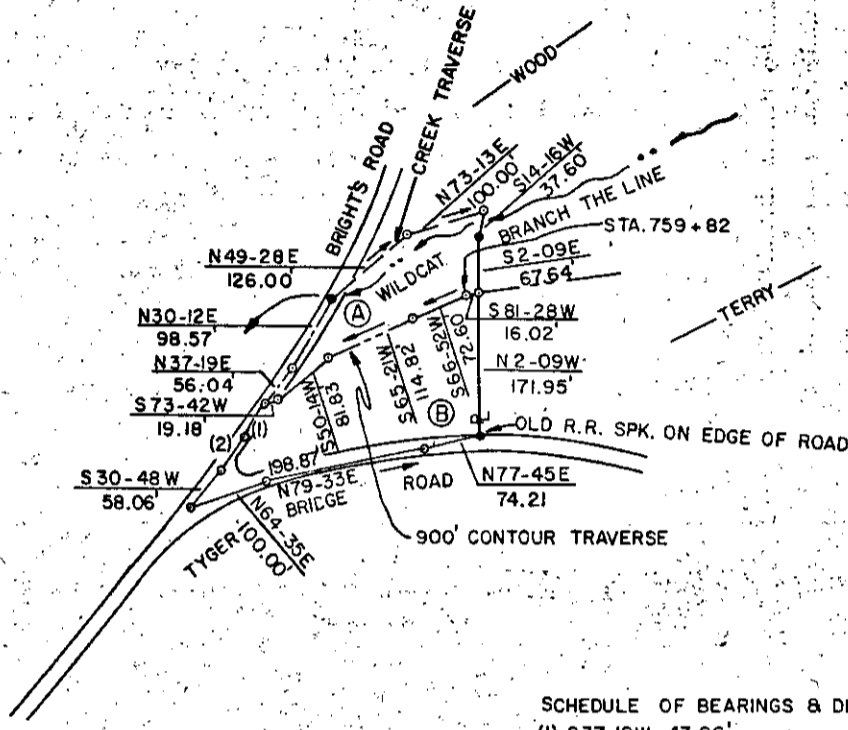


Nov 14 10 50 AM '75

✓ 40-293

DONNIE S. TANKERSLEY  
R.M.C.

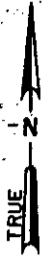

SCHEDULE OF BEARINGS & DISTANCES

- (1) S37-19W 43.96'
- (2) S31-06W 52.81'

TRACT A 0.48 ACRE BELOW 900' CONTOUR  
TRACT B 0.97 ACRE ABOVE 900' CONTOUR  
1.45 ACRES TOTAL

R=PROPERTY LINE  
●=OLD IRON PIN

12857  
NOV 14 1975

RECORDING FEE

PAID \$ 1.25

REFERENCES

DEED BOOK: 678-509  
BLOCK BOOK: 642.1-1-16.1

◇			
◇	1-30-75	TMA	TRACT B ADDED
REV.	DATE	BY	DESCRIPTION

REVISION

  
**enwright associates**  
ENGINEERS  
GREENVILLE, S.C.

GREER COMMISSION OF PUBLIC WORKS  
**LAKE JOHN A. ROBINSON**

PROPERTY OF  
~~JAMES WHITE~~  
*Alvin Terry*

LOCATED NEAR GREER

GREENVILLE CO. SOUTH CAROLINA

FILE NO.	CLIENTS.	RETIRED.			
	G.C.P.W.				
C.E.S. DRAWN.	DESIGN.	F.E.B. CHECK.	10-23-74 DATE.	1"=200FEET SCALE.	71523-46-A