
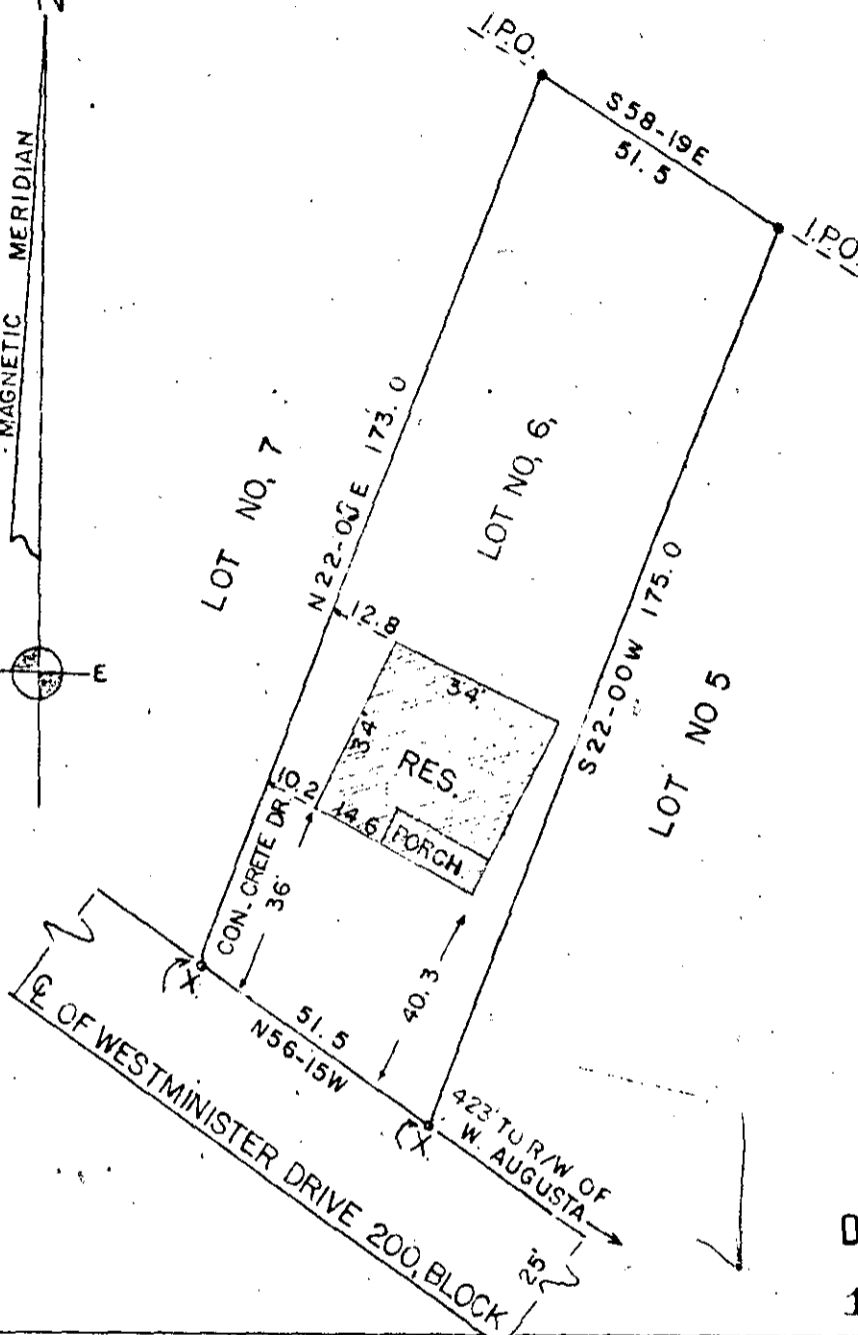


4-0-357

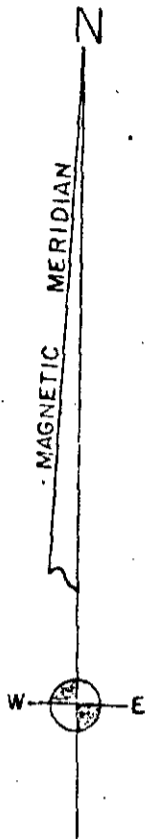

FILED  
 GREENVILLE CO. S. C.  
 DEC 16 10 47 AM '76  
 DONNIE S. TANKERSLEY  
 R.M.C.

DEC 16 1976  
 16266

CHARLES K. DUNN &  
 DEAN C. EDENS ASSOCIATES.  
 Registered surveyor NO. 1578  
 MT. FOREST CIRCLE.  
 EASLEY SOUTH CAROLINA 29640.  
 PHONE 859-8325

TITLE PROPERTY OF  
**NELLIE E. WALKER**  
 LOCATED IN THE 200, BLOCK OF WESTMINISTER DR.  
 STATE S.C. COUNTY GREENVILLE  
 SCALE 1" = 50' DATE MARCH 31, 1975 REF. NO. 968.P.240

7382 EC 160

725 M 432 EC 160

.13 M