HB-204
PG 6

4-0-372

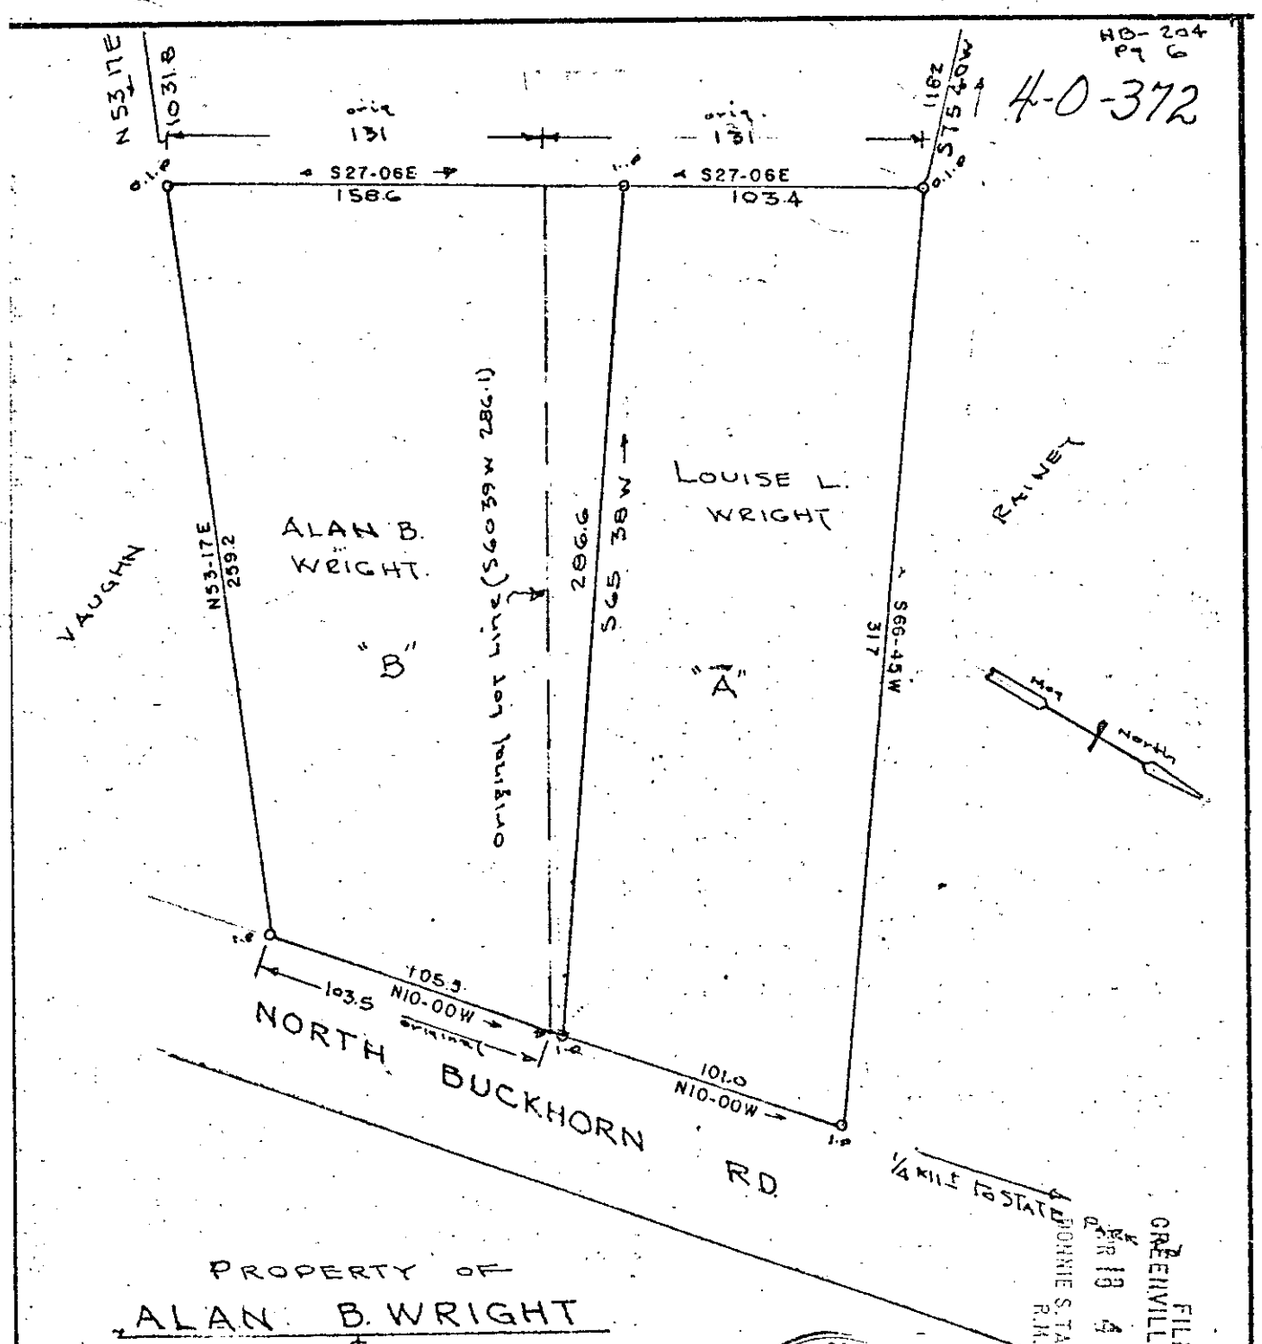


PROPERTY OF
ALAN B. WRIGHT
&
LOUISE L. WRIGHT
GREENVILLE Co. S.C.

Scale 1"=50'
3 4 9E PR 18C
3 5 0E PR 18C

APR 15-1977
1.25 A4
.13 A4

SOUTH CAROLINA
REGISTERED PROFESSIONAL ENGINEER AND LAND SURVEYOR
1144
CLIFFORD C. JONES

FILED
GREENVILLE CO. S.C.
APR 18 4 19 PM '77
DONNIE S. TANKERSLEY
R.M.C.

27883

4-0-372

APR 18 1977

JONES ENGINEERING SERVICE 1004 E. PERRY RD.