


V4-0-388


Note: Plat amended Sept. 7 1977  
to show 0.35 Acre.



FILED  
GREENVILLE CO. S.C.  
JUN 12 3 54 PM '78  
DONNIE S. TAKERSLEY  
R.H.C.

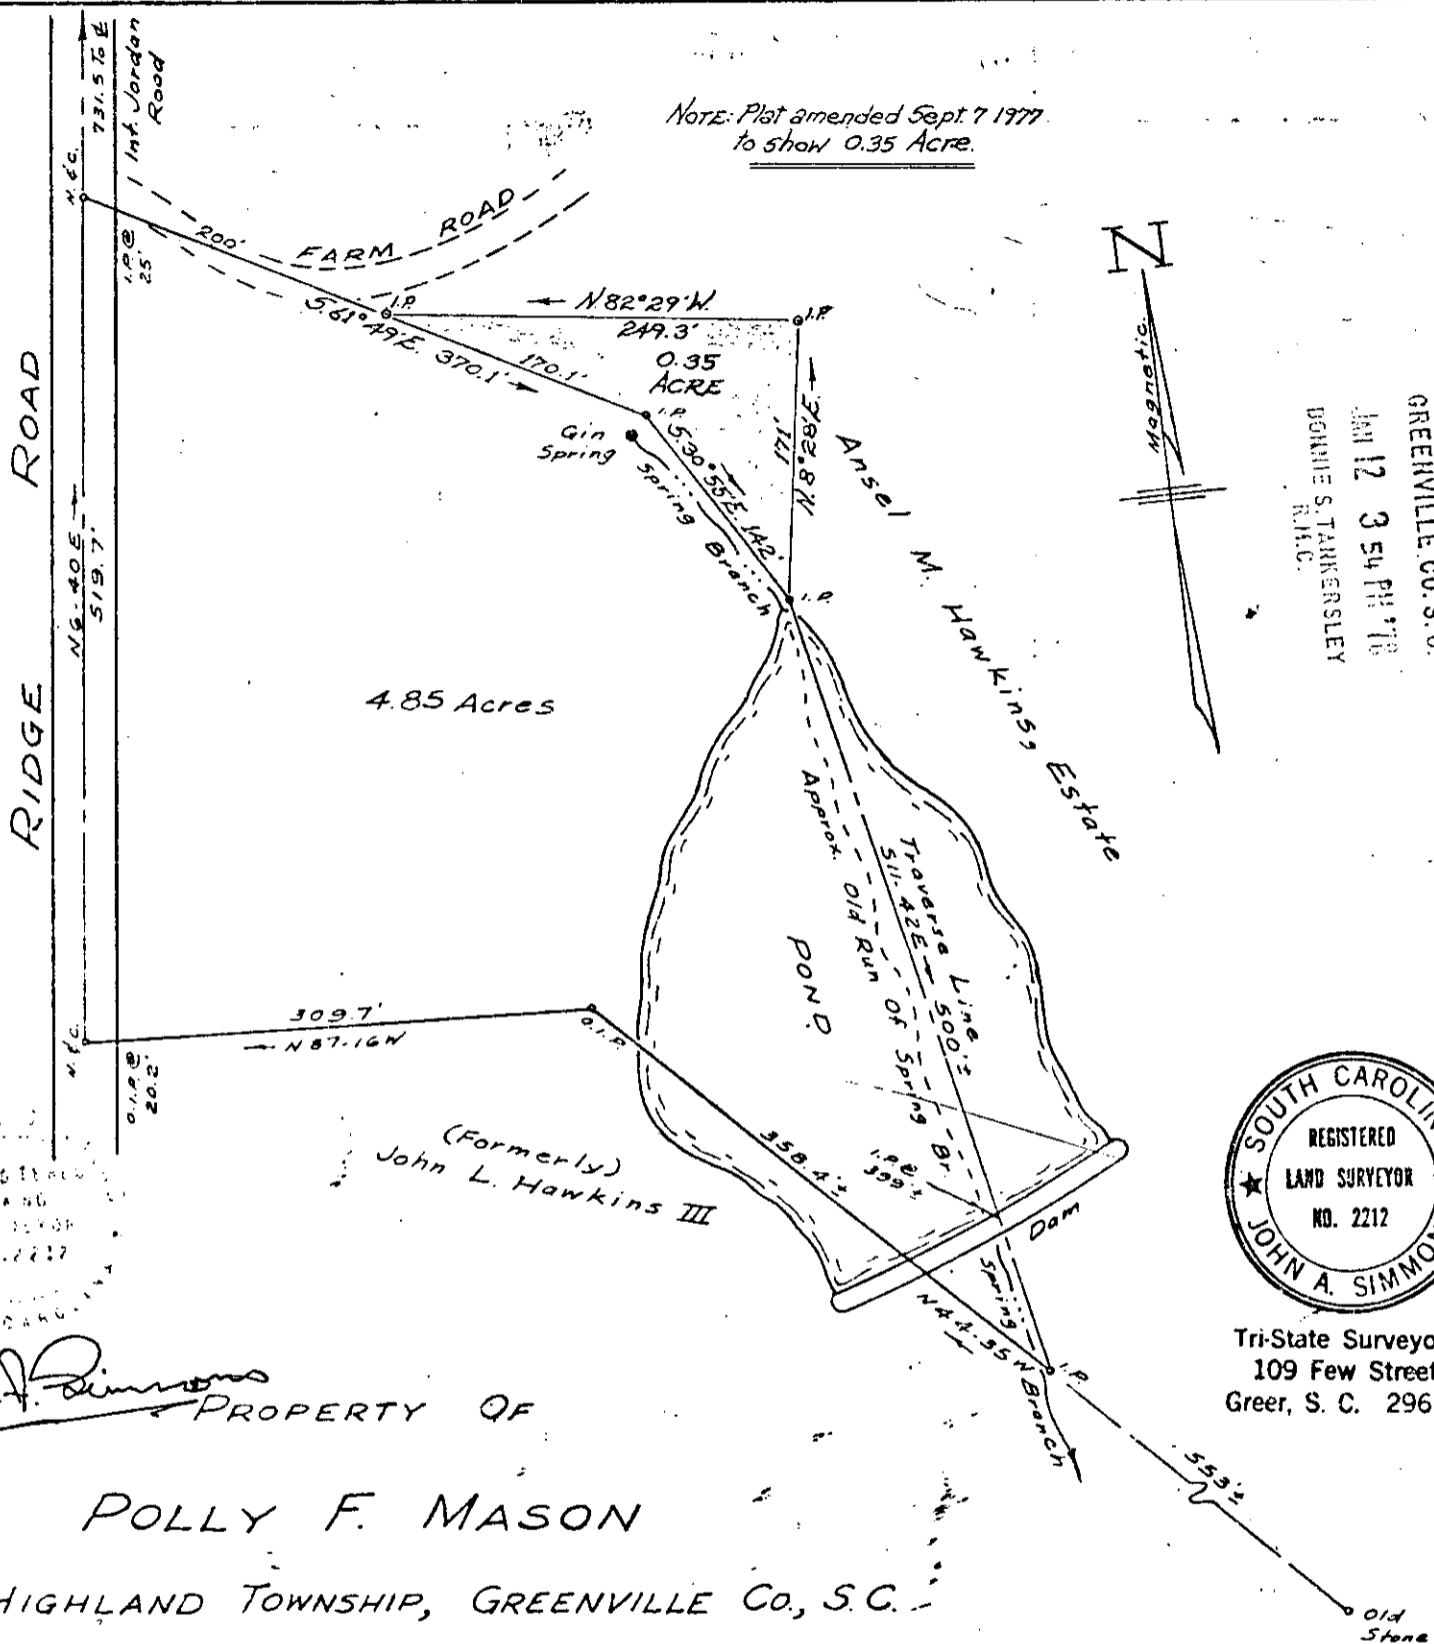

Tri-State Surveyors  
109 Few Street  
Greer, S. C. 29651

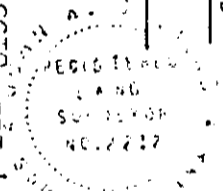

PROPERTY OF  
**POLLY F. MASON**  
HIGHLAND TOWNSHIP, GREENVILLE CO., S.C.

SCALE: 1" = 100' NOV. 1976

20897

Note: Information Taken From Plat Of  
John L. Hawkins, Estate By  
John A. Simmons, Surveyor,  
April 23, 1964.

Photo